


Latitude 38° 10'

Longitude 81° 25'

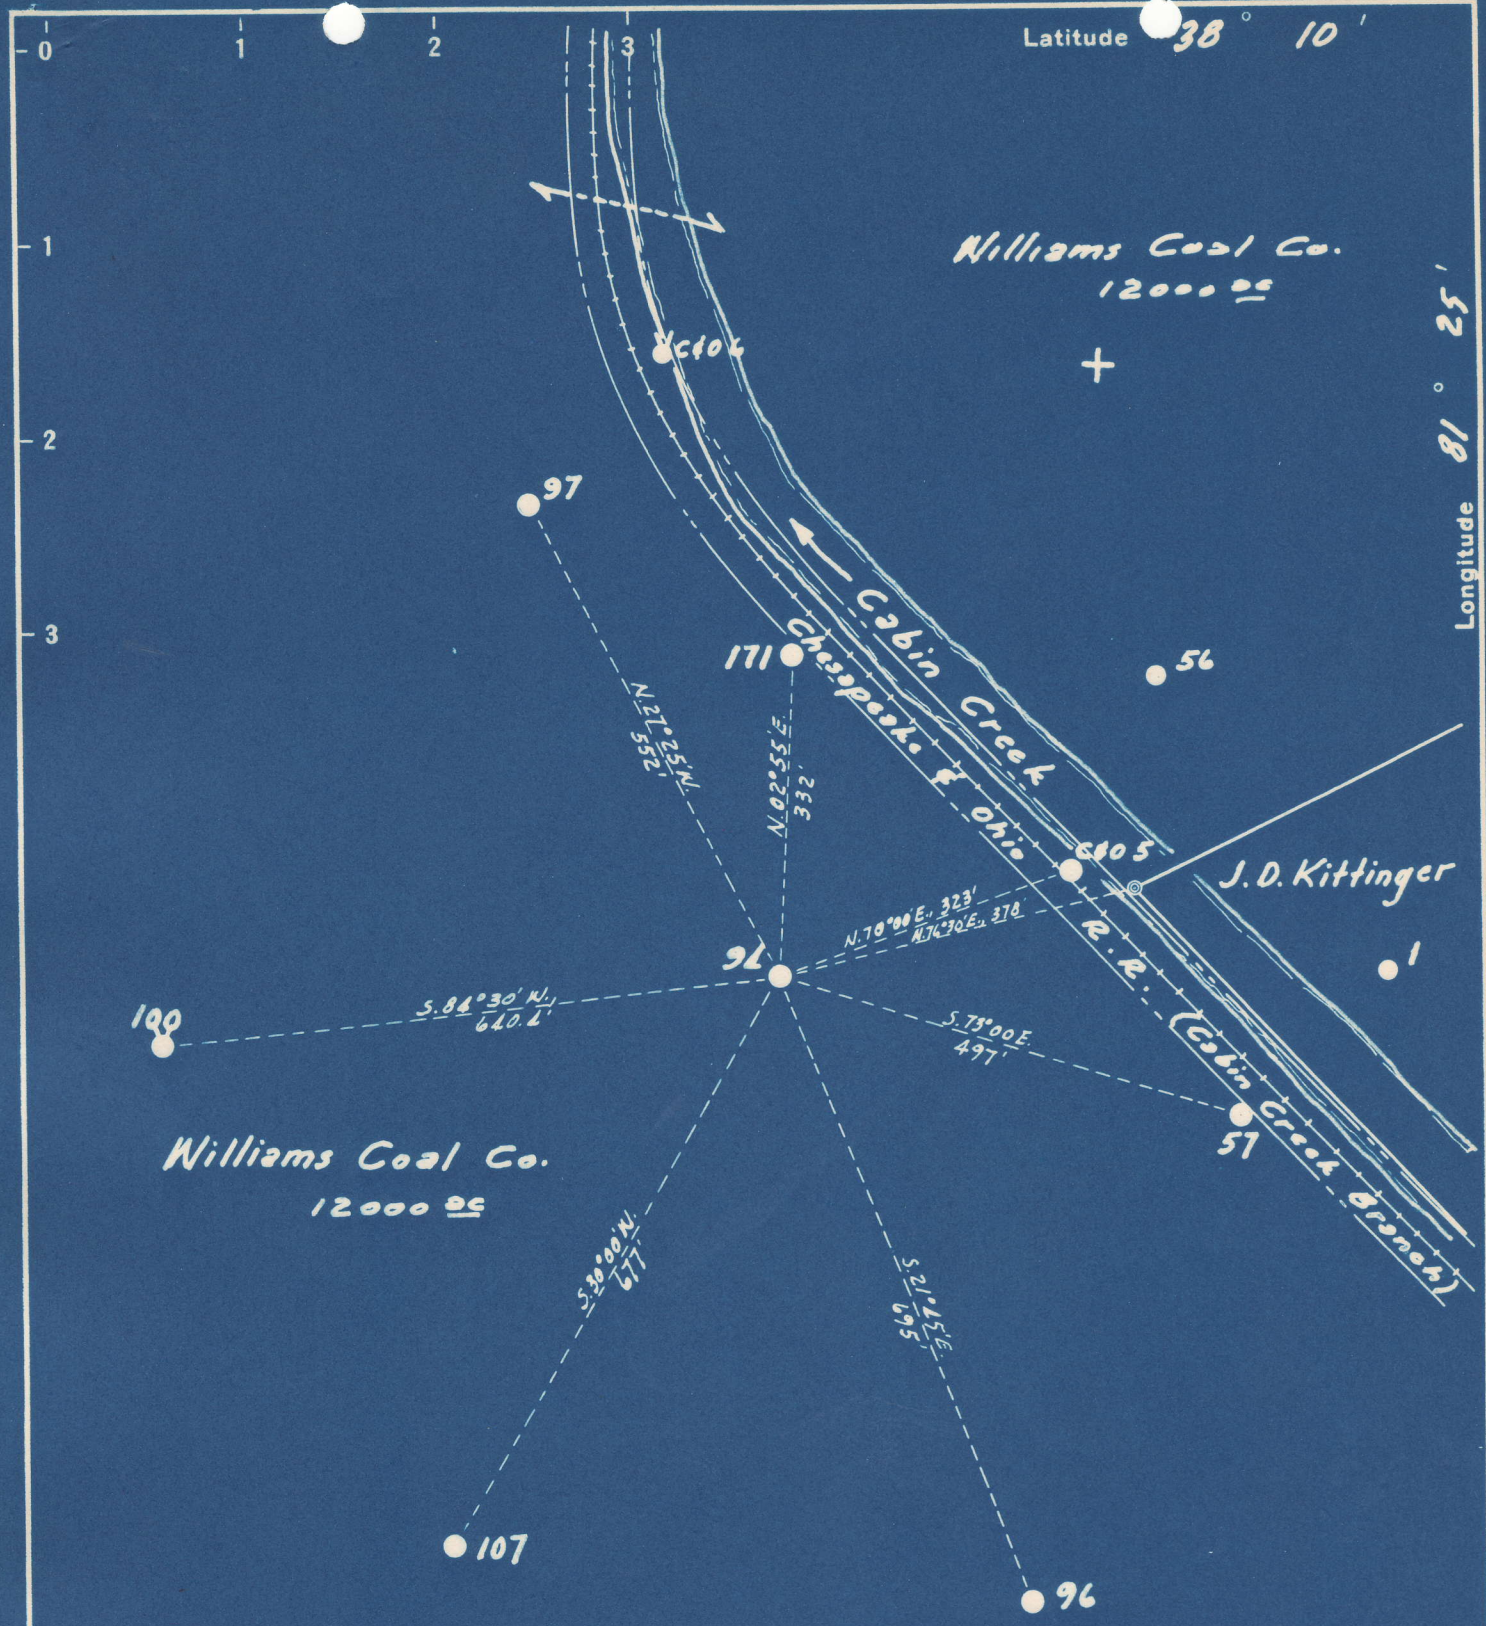

1.87 S
1.99 W

New Location
 Drill Deeper
 Abandonment

Company The Pure Oil Co
 Address Newark, Ohio Box 551
 Farm Williams Coal Co.
 Tract _____ Acres 12000 Lease No. 5012
 Well (Farm) No. 94 Serial No. 265
 Elevation (Spirit Level) 748.5
 Quadrangle Montgomery WC
 County Konowho District Cabin Creek
 Engineer J. B. Hunter
 Engineer's Registration No. Ohio 2912
 File No. _____ Drawing No. _____
 Date Aug. 31, 1948 Scale 1" = 200'

STATE OF WEST VIRGINIA
 DEPARTMENT OF MINES
 OIL AND GAS DIVISION
 CHARLESTON

WELL LOCATION MAP
 FILE NO. KAN-556-A

+ Denotes location of well on United States Topographic Maps, scale 1 to 62,500, latitude and longitude lines being represented by border lines as shown.

- Denotes one inch spaces on border line of original tracing.