

New Location
 Drill Deeper
 Abandonment

Company EVERITT-WHITING INC.
KANAWHA ACCOUNT
 Address OKEMAH, OKLA.
 Farm THOS. BANNISTER HRS.
 Tract _____ Acres 200 Lease No. _____
 Well (Farm) No. 13 Serial No. _____
 Elevation (Spirit Level) 941.44
 Quadrangle CLENDENNIN
 County KANAWHA District ELK
 Engineer L. F. Rye
 Engineer's Registration No. 804
 File No. _____ Drawing No. _____
 Date 2-22-49 Scale 1" = 500'

NW

STATE OF WEST VIRGINIA
 DEPARTMENT OF MINES
 OIL AND GAS DIVISION
 CHARLESTON

WELL LOCATION MAP

FILE NO. KAN-613-A

+ Denotes location of well on United States Topographic Maps, scale 1 to 62,500, latitude and longitude lines being represented by border lines as shown.

- Denotes one inch spaces on border line of original tracing.

6-0 217

BANNISTER HEIRS NO. 13 WELL.

613A

Elk District, Kanawha County, W. Va.
By Everitt-Whiting, Inc., Okemah, Okla.
Abandoned under permit Kan-.....-A?

On 200 acres, on Elk River.

Elevation, 941.44' L.

Drilling completed Oct. 3, 1912.

Shot record: 2070', 30 qts.; Feb. 20, 1913, at 2072', with 50 qts.;
Mar. 30, 1914, with 60 qts.; Apr. 10, 1914, at 2075', with 120 qts.;
Nov. 10, 1916, at 2074-2093', with 120 qts.; May 2, 1927, at
2070-2086', with 140 qts.; and Mar. 24, 1936, at 2070-2086', with
40 qts.

8 $\frac{1}{2}$ " casing, 577'; 7" O. D., 1830'; 2" tubing, 2088'; all left in.
Oil well. Record to Dept. of Mines stamped March 5, 1949.

Record to RGT from Mrs. Griffith May 21, 1949. Old File No. 1383.

	Top.	Bottom.
Big Lime	1815	- 1953
Big Injun Sand	1953	- 1998
Squaw Sand (oil and gas, 2070')	2065	- 2087
Total depth		2088



Completed no inspection

1383

STATE OF WEST VIRGINIA
DEPARTMENT OF MINES
OIL AND GAS DIVISION

WELL RECORD

Oil or Gas Well (KIND)


Permit No. Ab 613-A

Company Everitt-Whiting, Inc.,
 Address Okemah, Okla.
 Farm Bannister heirs Acres 200
 Location (waters) Elk River
 Well No. 13 Elev. 941.44'
 District Elk County Kanawha
 The surface of tract is owned in fee by _____
 Address _____
 Mineral rights are owned by _____
 Address _____
 Drilling commenced _____
 Drilling completed October 3, 1912
 Date Shot _____ From _____ To _____
 With _____
 Open Flow _____ /10ths Water in _____ Inch
 _____ /10ths Merc. in _____ Inch
 Volume _____ Cu. Ft.
 Rock Pressure _____ lbs. _____ hrs.
 Oil _____ bbls., 1st 24 hrs.
 Fresh water _____ feet _____ feet
 Salt water _____ feet _____ feet

Casing and Tubing	Used in Drilling	Left in Well	Packers
Size			Kind of Packer
16			
13			
10			Size of
8 1/4 - 8-5/8"	577	577	Depth set
6 1/2			
5 3/16	1830	1830	Perf. top
3			Perf. bottom
2	2088	2088'	Perf. top
Liners Used			Perf. bottom

CASING CEMENTED _____ SIZE _____ No. Ft. _____ Date _____
 COAL WAS ENCOUNTERED AT _____ FEET _____ INCHES
 _____ FEET _____ INCHES _____ FEET _____ INCHES
 _____ FEET _____ INCHES _____ FEET _____ INCHES

Formation	Color	Hard or Soft	Top	Bottom	Oil, Gas or Water	Depth Found	Remarks
Big Lime			1815	1953			
Big Injun			1953	1998			
Squaw Sand			2065	2087			
Oil and Gas			2070				
Total Depth				2088'			
SHOT RECORD			2070'	30 qts.			
2/20/1913			2072'	50 "			
3/30/1914			not shown	60 "			
4/10/1914			2075	120 "			
11/10/1916			2074	2093'	120 qts.		
5/2/1927			2070	2086'	140 "		
3/24/1956			2070	2086'	40 "		

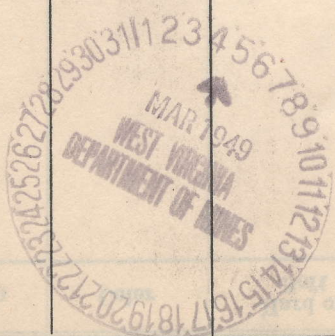

(Over)

MAY 21 1949