



New Location...   
 Drill Deeper...   
 Abandonment...

Company UNITED FUEL GAS CO  
 Address CHARLESTON, W.VA.  
 Farm G.B. MYERS  
 Tract \_\_\_\_\_ Acres 65 Lease No. 807  
 Well (Farm) No. 1, 3 Serial No. 2847  
 Elevation (Spirit Level) 1-994, 3-826  
 Quadrangle CLENDENIN  
 County KANAWHA District ELK  
 Engineer J.H. Moore  
 Engineer's Registration No. 662  
 File No. 70-63 Drawing No. \_\_\_\_\_  
 Date 4-19-49 Scale 1" = 400'

STATE OF WEST VIRGINIA  
 DEPARTMENT OF MINES  
 OIL AND GAS DIVISION  
 CHARLESTON

**WELL LOCATION MAP**

FILE NO. KAN-633-A-#2847  
KAN-635-A-#3292

+ Denotes location of well on United States Topographic Maps, scale 1 to 62,500, latitude and longitude lines being represented by border lines as shown.

- Denotes one inch spaces on border line of original tracing.

6-6-49



G. B. MYERS NO. 2847 WELL.

633A

Elk District, Kanawha County, W. Va.

By United Fuel Gas Co., Box 1273, Charleston, 25, W. Va.

Abandoned under permit Kan-.....-A7

On 65 acres, on Pinch Creek.

Elevation, 994' L.

Minerals owned by Daniel Matthews, Capitol City Bank, Attorney,  
Charleston, W. Va.

Drilling commenced July 13, 1912; completed Aug. 24, 1912.

Date shot, not given.

Oil, 10 bbls., 1st 24 hrs.

8 1/2" casing, 510' (pulled); 5 1/2", 1796'; 2" tubing, 2138'.

Coal was encountered at 210-215 and 430-434'.

Oil well. Record to Dept. of Mines dated April 20, 1949.

Record to RCT from Mrs. Griffith Nov. 4, 1949. Old File No. 1415.

	Top.	Bottom.
Mud	0	14
Slate and shells	14	100
Sand	100	160
Slate	160	210
Coal	210	215
Sand	215	360
Slate	360	430
Coal	430	434
Slate	434	510
Sand	510	740
Slate and shells	740	900
Sandy lime	900	1050
Salt Sand	1050	1500
Slate	1500	1540
Sand	1540	1560
Red rock	1560	1572
Slate and shells	1572	1600
Little Lime	1600	1630
Slate	1630	1645
Lime	1645	1651
Red rock	1651	1665
Black lime	1665	1677
Pencil Cave	1677	1685
Big Lime	1685	1840
Broken sand	1840	1948
Squaw Sand	1948	1968
Broken sand	1968	2078
2nd Squaw Sand	2072	2093
Total depth		2138





STATE OF WEST VIRGINIA  
DEPARTMENT OF MINES  
OIL AND GAS DIVISION

1415

WELL RECORD  
ABANDONMENT

Oil or Gas Well Oil  
(KIND)

Permit No. Ab 633-A


Company United Fuel Gas Company  
Address P. O. Box 1273, Charleston 25, W. Va.  
Farm G. B. Myers Acres 65  
Location (waters) Pinch Creek  
Well No. 2847 Elev. 994  
District Elk County Kanawha  
The surface of tract is owned in fee by \_\_\_\_\_  
Address \_\_\_\_\_  
Mineral rights are owned by Daniel Matthews  
Capitol City Bank Atty. Address Chas., W. Va.  
Drilling commenced 7-13-12  
Drilling completed 8-24-12  
Date Shot Not Given From \_\_\_\_\_ To \_\_\_\_\_  
With \_\_\_\_\_

Casing and Tubing	Used in Drilling	Left in Well	Packers
Size			Kind of Packer
16			
13			
10			Size of
8 1/4	510	Pulled	
6 5/8			Depth set
5 3/16	1796	1796	
3			Perf. top
2 Tubing		2138	Perf. bottom
Liners Used			Perf. top
			Perf. bottom

Open Flow \_\_\_\_\_ /10ths Water in \_\_\_\_\_ Inch  
\_\_\_\_\_ /10ths Merc. in \_\_\_\_\_ Inch  
Volume \_\_\_\_\_ Cu. Ft.  
Rock Pressure \_\_\_\_\_ lbs. \_\_\_\_\_ hrs.  
Oil 10 bbls., 1st 24 hrs.  
Fresh water \_\_\_\_\_ feet  
Salt water \_\_\_\_\_ feet

CASING CEMENTED \_\_\_\_\_ SIZE \_\_\_\_\_ No. Ft. \_\_\_\_\_ Date \_\_\_\_\_  
COAL WAS ENCOUNTERED AT 210 FEET 60 INCHES  
430 FEET 48 INCHES FEET INCHES  
FEET INCHES FEET INCHES

Formation	Color	Hard or Soft	Top	Bottom	Oil, Gas or Water	Depth Found	Remarks
Mud				14			
Slate & Shells			14	100			
Sand			100	160			
Slate			160	210			
Coal			210	215			
Sand			215	360			
Slate			360	430			
Coal			430	434			
Slate			434	510			
Sand			510	740			
Slate & Shells			740	900			
Sandy Lime			900	1050			
Salt Sand			1050	1500			
Slate			1500	1540			
Sand			1540	1560			
Red Rock			1560	1572			
Slate & Shells			1572	1600			
Little Lime			1600	1630			
Slate			1630	1645			
Lime			1645	1651			
Red Rock			1651	1665			
Black Lime			1665	1677			
Pencil Cave			1677	1685			
Big Lime			1685	1840			
Broken Sand			1840	1948			
Squaw Sand			1948	1968			
Broken Sand			1968	2078			
2nd Squaw Sand			2072	2093			
Total Depth				2138'			

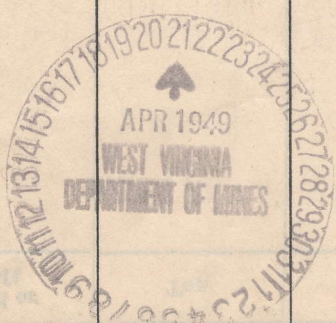

(Over)

NOV - 4 1940



