

Company The Pure Oil Co.

Address Newark, Ohio Box 551

Farm Chesapeake & Ohio R.R. R-O-N

Tract \_\_\_\_\_ Acres 10 Lease No. 5031

Well (Farm) No. 5 Serial No. 322

Elevation (Spirit Level) 693

Quadrangle Montgomery

County Kanawha District Cabin Creek

Engineer J.B. Hunter

Engineer's Registration No. Ohio-2912

File No. \_\_\_\_\_ Drawing No. \_\_\_\_\_

Date 2-1-50 Scale 1" = 200'

STATE OF WEST VIRGINIA  
DEPARTMENT OF MINES  
OIL AND GAS DIVISION  
CHARLESTON

WELL LOCATION MAP  
FILE NO. KAN-688-A

+ Denotes location of well on United States Topographic Maps, scale 1 to 62,500, latitude and longitude lines being represented by border lines as shown.

- Denotes one inch spaces on border line of original tracing.



STATE OF WEST VIRGINIA  
DEPARTMENT OF MINES  
OIL AND GAS DIVISION

1572

WELL RECORD

Permit No. 688-A

Oil or Gas Well Oil  
(KIND)


Company The Pure Oil Co.  
Address PO Bx 551 - Newark, Ohio  
Farm C. & O. R/W Acres 10  
Location (waters) Cabin Creek  
Well No. 5 Elev. 693.0  
District Cabin Creek County Kanawha  
The surface of tract is owned in fee by C&O Railway Co.  
Mr. R.O. Robertson-Gen Real Estate Agent,  
Address Huntington, W. Va.  
Mineral rights are owned by SAME AS ABOVE  
Address \_\_\_\_\_  
Drilling commenced No record  
Drilling completed \_\_\_\_\_  
Date Shot 11/6/19 From 2380' To 2400'  
12/18/20 From 2380' To 2400'  
With 40 Qts. 90 Qts.  
Open Flow /10ths Water in Inch  
/10ths Merc. in Inch  
Volume \_\_\_\_\_ Cu. Ft.  
Rock Pressure \_\_\_\_\_ lbs. \_\_\_\_\_ hrs.  
Oil NR bbls., 1st 24 hrs.  
Fresh water \_\_\_\_\_ feet \_\_\_\_\_ feet  
Salt water \_\_\_\_\_ feet \_\_\_\_\_ feet

Casing and Tubing	Used in Drilling	Left in Well	Packers
Size			Kind of Packer
16			
13			
10	<u>420'</u>	<u>420'</u>	Size of
8 1/4			
6 5/8	<u>1710'</u>	<u>1710'</u>	Depth set
5 3/16			
3			Perf. top
2			Perf. bottom
Liners Used			Perf. top
			Perf. bottom

CASING CEMENTED \_\_\_\_\_ SIZE \_\_\_\_\_ No. Ft. \_\_\_\_\_ Date \_\_\_\_\_

COAL WAS ENCOUNTERED AT \_\_\_\_\_ FEET \_\_\_\_\_ INCHES  
\_\_\_\_\_ FEET \_\_\_\_\_ INCHES \_\_\_\_\_ FEET \_\_\_\_\_ INCHES  
\_\_\_\_\_ FEET \_\_\_\_\_ INCHES \_\_\_\_\_ FEET \_\_\_\_\_ INCHES

Formation	Color	Hard or Soft	Top	Bottom	Oil, Gas or Water	Depth Found	Remarks
Well purchased from Lawrence Oil & Gas Co. 1/1/27 No log is available, neither is the position of a single marker bed known from this hole. The following formations and depths are interpolated by use of Pure's Williams Coal Co. #171.							
Grampus			530	700			
Slate			700	737			
Salt Sand			737	1028			
Maxon Sand			1498	1587			
Little Lime			1587	1614			
Big Lime			1664	1900			
Berea Sand			2318				
			TOTAL DEPTH	2400			

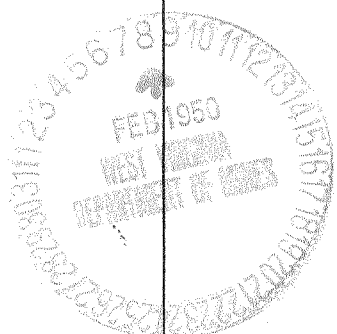

(Over)

FEB 22 1951

Formation	Color	Hard or Soft	Top	Bottom	Oil, Gas or Water	Depth Found	Remarks

Date February 7, 1950  
THE PURE OIL COMPANY P.O. BOX 551  
Newark, Ohio, Owner

APPROVED

By

*Fred Willey*  
Senior Superintendent (Title)