

#	703-A	S	5.45
#	2468	W	2.45
#	706-A	S	5.71
#	2486	W	2.55

#	698-A	S	5.61
#	2476	W	2.30
#	699-A	S	5.34
#	2478	W	2.54

KAN-698-A	-#2476
KAN-699-A	-#2478
KAN-703-A	-#2468
KAN-706-A	-#2486

New Location...
 Drill Deeper...
 Abandonment...

Company SAM BEREN
 Address 516 - 4th. ST., MARIETTA, OHIO
 Farm DAVID WARD
 Tract _____ Acres 8000 Lease No. 25660
 Well (Farm) No. 27-35 Serial No. 2468
37-45 2476
 Elevation (Spirit Level) SEE ABOVE 2478
2486
 Quadrangle GLENDENIN
 County KANAWHA District CABIN CREEK.
 Engineer C. E. KUB
 Engineer's Registration No. 9 SC
 File No. _____ Drawing No. _____
 Date 8-12-49 Scale 1" - 600'

STATE OF WEST VIRGINIA
 DEPARTMENT OF MINES
 OIL AND GAS DIVISION
 CHARLESTON

WELL LOCATION MAP
 FILE NO. SEE ABOVE

+ Denotes location of well on United States Topographic Maps, scale 1 to 62,500, latitude and longitude lines being represented by border lines as shown.

- Denotes one inch spaces on border line of original tracing.

DAVID WARD NO. 2468 WELL.

703A

Cabin Creek District, Kanawha County, W. Va.
 By W. L. Thaxton, Box 147, Sissonville, W. Va.
 Abandoned under permit Kan-.....-A?

On 8,000 acres, on Kelly Creek.

Elevation, 1384' L.

Drilling commenced Jan. 21, 1919; completed March 29, 1919.

13" casing, 16'; 10", 201'; 8", 1102' (pulled); 6", 1518'; 2" tubing, 1945'

Oil well. Record to Dept. of Mines stamped March 9, 1950.

Record to RCT from Mrs. Griffith May 26, 1950. Old File No. 1457.

	Top.	Bottom.
Gravel	0	15
Slate and shells	15	128
Coal	128	132
Slate and shell (hole full water, 220')	132	520
Sand	520	615
Slate	615	620
1st Salt Sand	620	715
Slate	715	775
2nd Salt Sand	775	920
Slate	920	978
3rd Salt Sand	978	1070
White slate	1070	1086
Red rock	1086	1100
Shell and sand	1100	1282
Red rock	1282	1311
Slate and shell	1311	1426
Little Lime	1426	1476
Pencil Cave	1476	1490
Big Lime	1490	1700
Big Injun Sand	1700	1738
Slate and shell	1738	1760
Weir Sand (gas, 1772', 21/10 W. 3") (oil, 1925-1931')	1760	1945
Total depth		1945



STATE OF WEST VIRGINIA
DEPARTMENT OF MINES
OIL AND GAS DIVISION

1457

WELL RECORD

Permit No. KAN-703-A


Oil or Gas Well _____
(KIND)

Company W. L. Thaxton
Address Box 147 - Sissonville, W. Va.
Farm David Ward Acres 8000
Location (waters) Kelleys Creek
Well No. 2468 Elev. 1384'
District Cabin Creek County Kanawha
The surface of tract is owned in fee by _____
Address _____
Mineral rights are owned by _____
Address _____
Drilling commenced January 21, 1919
Drilling completed March 29, 1919
Date Shot _____ From _____ To _____
With _____
Open Flow _____ /10ths Water in _____ Inch
_____ /10ths Merc. in _____ Inch
Volume _____ Cu. Ft.
Rock Pressure _____ lbs. _____ hrs.
Oil _____ bbls., 1st 24 hrs.
Fresh water _____ feet _____ feet
Salt water _____ feet _____ feet

Casing and Tubing	Used in Drilling	Left in Well	Packers
Size			Kind of Packer
16			
13	16'	16'	
10	201'	201'	Size of
8 1/4	1102'	--	
6 5/8	1518'	1518'	Depth set
5 3/16			
3			Perf. top
2	1945'	1945'	Perf. bottom
Liners Used			Perf. top
			Perf. bottom

CASING CEMENTED _____ SIZE _____ No. Ft. _____ Date _____
COAL WAS ENCOUNTERED AT _____ FEET _____ INCHES
_____ FEET _____ INCHES FEET _____ INCHES
_____ FEET _____ INCHES FEET _____ INCHES

Formation	Color	Hard or Soft	Top	Bottom	Oil, Gas or Water	Depth Found	Remarks
Gravel				15			
Slate & shells			15	128			
Coal			128	132			
Slate & shell			132	520			Hole full of water 220'
Sand			520	615			
Slate			615	620			
1st Salt Sand			620	715			
Slate			715	775			
2nd Salt Sand			775	920			
Slate			920	978			
3rd. Salt Sand			978	1070			
White Slate			1070	1086			
Red Rock			1086	1100			
Shell & sand			1100	1282			
Red Rock			1282	1311			
Slate & shell			1311	1426			
Little Lime			1426	1476			
Pencil Cave			1476	1490			
Big Lime			1490	1700			
Injun			1700	1738			
Slate & shell			1738	1760			
Weir			1760	1945			Gas 1772' -- 21/10 W. 3"
Total Depth				1945			Oil 1925'-1931'

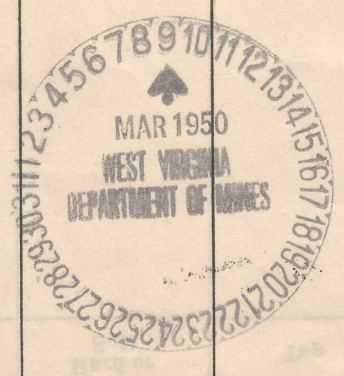

1518
1104
1604

(Over) MAY 26 1950