

New Location..
 Drill Deeper.....
 Abandonment.....

S 2.70
 W 2.47

Company COLUMBIAN CARBON COMPANY
 Address P.O. Box 873 CHARLESTON, W.VA.
 Farm NANNIE E. HUNT
 Tract _____ Acres 80 Lease No. C2944
 Well (Farm) No. 2 Serial No. GW 852
 Elevation (Spirit Level) 953
 Quadrangle WALTON 9 S.W. S271 W249
 County KANAWHA District POCA
 Engineer R. B. Anderson
 Engineer's Registration No. 2074
 File No. _____ Drawing No. _____
 Date JUNE 23, 1950 Scale 1" = 660'

STATE OF WEST VIRGINIA
 DEPARTMENT OF MINES
 OIL AND GAS DIVISION
 CHARLESTON,
WELL LOCATION MAP
 FILE NO. KAN-739-A-2

+ Denotes location of well on United States Topographic Maps, scale 1 to 62,500, latitude and longitude lines being represented by border lines as shown.
 - Denotes one inch spaces on border line of original tracing.

6-6 (198)

NANNIE E. HUNT NO. 2 WELL.

739A

Elk District, Kanawha County, W. Va.
 By Columbian Carbon Co., (Empire Petroleum Co., part interest),
 Charleston, W. Va.
 Abandoned under permit Kan-.... -A?
 On.....acres.
 Elevation,' L.
 Drilling commenced June 1926; completed Aug. 12, 1926.
 Shot June 3, 1930, at 1932-1937'.
 10 $\frac{3}{4}$ " casing, 27'; 8 $\frac{1}{2}$ " , 590' (pulled); 6 $\frac{5}{8}$ " , 1903'; 2" tubing, 1976'.
 Gas well. Record to Dept. of Mines stamped June 23, 1950.
 Record to RCT from Mrs. Griffith Nov. 18, 1950. Old File No. 1491.

	Top.	Bottom.
Soil	0	10
Sand	10	150
Shells and red rock	150	340
Slate, black	340	576?
Little Dunkard Sand	570?	642
Slate	642	652
Big Dunkard Sand	652	751
Slate	751	779
Black lime	779	890
Sand	890	985
Slate	985	1150
Sand	1150	1188
Slate	1188	1212
Sand	1212	1293
Slate	1293	1298
Salt Sand (oil and water at 1380')	1298	1530
Slate	1530	1540
Salt Sand	1540	1680
Lime	1680	1728
Maxton Sand	1728	1750
Little Lime	1750	1765
Slate	1765	1771
Black lime	1771	1786
Big Lime (gas, 1862', 5/10 W. 2", 73 M. cu. ft.)	1786	1918
Big Injun Sand	1918	1930
Slate	1930	1931
Big Injun Sand (gas at 1931', 3/10 W. 2", 73 M. cu. ft.)	1931	1948
Slate (gas, 1938', 6/10 W. 2", 73 M.)	1948	1976
Total depth		1976

field (198)



STATE OF WEST VIRGINIA
DEPARTMENT OF MINES
OIL AND GAS DIVISION

1491

Inspector's records

Permit No. KAN-739-A
Columbian Carbon Company

Oil or Gas Well Gas
(KIND)


WELL RECORD

Company Empire Petroleum Company
 Address (part interest)
 Farm Hannie E. Hunt Acres _____
 Location (waters) _____
 Well No. 2 Elev. _____
 District Elk County Kanawha
 The surface of tract is owned in fee by _____
 Address _____
 Mineral rights are owned by _____
 Address _____
 Drilling commenced June 1926
 Drilling completed Aug. 12-1926
 Date Shot 6-3-30 From 1932 To 1937
 With _____
 Open Flow /10ths Water in _____ Inch
 /10ths Merc. in _____ Inch
 Volume _____ Cu. Ft.
 Rock Pressure _____ lbs. _____ hrs.
 Oil _____ bbls., 1st 24 hrs.
 Fresh water _____ feet _____ feet
 Salt water _____ feet _____ feet

Casing and Tubing	Used in Drilling	Left in Well	Packers
Size			
16			Kind of Packer
13			
10"	27'	27'	Size of
8 1/4"	590'	590'	Depth set
6 5/8"	1803'	1803'	
5 3/16"			
3"			Perf. top
2"	1976'	1976'	Perf. bottom
Liners Used			Perf. top
			Perf. bottom

CASING CEMENTED _____ SIZE _____ No. Ft. _____ Date _____
 COAL WAS ENCOUNTERED AT _____ FEET _____ INCHES
 _____ FEET _____ INCHES FEET _____ INCHES
 _____ FEET _____ INCHES FEET _____ INCHES

Formation	Color	Hard or Soft	Top	Bottom	Oil, Gas or Water	Depth Found	Remarks
Soil			0	20			
Sand			10	150			
Shells & Red Rock			150	340			
Slate Black			340	576			
Little Dunkard			570	642			
Slate			642	652			
Big Dunkard Sand			652	751			
Slate			751	779			
Black Lime			779	890			
Sand			890	985	Oil & water at	1360'	
Slate			985	1150			
Sand			1150	1188	Gas at	1862' 5/10 W. 2" 73MCF	
Slate			1188	1212			
Sand			1212	1293	Gas at	1931' 3/10 W. 2" 73MCF	
Slate			1293	1298			
Salt Sand			1298	1530	Gas at	1938' 6/10. 2" 73MCF	
Slate			1530	1540			
Salt Sand			1540	1680			
Lime			1680	1728			
Maxon Sand			1728	1750			
Little Lime			1750	1765			
Slate			1765	1771			
Black Lime			1771	1786			
Big Lime			1786	1918			
Big Injun			1918	1930			
Slate			1930	1931			
Big Injun			1931	1948			
Slate			1948	1976			
TOTAL DEPTH				1976			

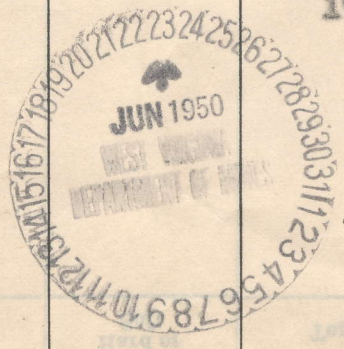

NOV 18 1950