

Company SAM BEREN
 Address 516-4th. ST., MARIETTA, OHIO
 Farm CHLOE COPENHAVER
 Tract _____ Acres 94.77 Lease No. 7425
 Well (Farm) No. 10-17 Serial No. 2879
 Elevation (Spirit Level) 642 - 723 ²⁹⁰⁰
 Quadrangle CLENDENIN
 County KANAWHA District ELK
 Engineer C. P. ...
 Engineer's Registration No. 9
 File No. _____ Drawing No. _____
 Date 9-22-49 Scale 1" - 200'

STATE OF WEST VIRGINIA
 DEPARTMENT OF MINES
 OIL AND GAS DIVISION
 CHARLESTON

WELL LOCATION MAP
 FILE NO. KAN-748-A-#10
KAN-749-A-#17

+ Denotes location of well on United States Topographic Maps, scale 1 to 62,500, latitude and longitude lines being represented by border lines as shown.

- Denotes one inch spaces on border line of original tracing.

CHLOE COPENHAVER #10 (2879) & #17 (2900) - SAM BEREN - KAN-748-749-A

CHLOE COFFENHAVER NO. 17 WELL.

749A

Elk District, Kanawha County, W. Va.

By Strauss & Beron, Marietta, Ohio.

Abandoned under permit Ken-.....-A?

On 94.77 acres, on Blue Creek.

Elevation, 723' L.

Coal not operated.

Drilling commenced May 18, 1912; completed July 3, 1912.

10" casing, 50'; 8 $\frac{1}{2}$ " , 516' (pulled); 6 $\frac{3}{8}$ " , 1489'.

Oil well. Record to Dept. of Mines stamped Aug. 17, 1950.

Record to RCT from Mrs. Griffith June 28, 1951. Old File No. 1553.

	Top.	Bottom.
Salt Sand	800	- 1295
Maxton Sand	1390	- 1415
Little Lime	1415	- 1445
Lime	1455	- 1465
Big Lime	1475	- 1610
Keener Sand	1610	- 1631
Oil sand (Weir)	1734	- 1754
Total depth		1759



1553

STATE OF WEST VIRGINIA
DEPARTMENT OF MINES
OIL AND GAS DIVISION

WELL RECORD

Permit No. 749-A

Oil or Gas Well _____
(KIND)


Company Strauss & Beren
 Address Marietta, Ohio
 Farm Chloe Copenhaver Acres 94.77
 Location (waters) Blue Creek
 Well No. 17 Elev. 723'
 District Blk County Kanawha
 The surface of tract is owned in fee by _____
 Address _____
 Mineral rights are owned by Coal Not Operated
 Address _____
 Drilling commenced May 18, 1912
 Drilling completed July 3, 1912
 Date Shot _____ From _____ To _____
 With _____
 Open Flow _____ /10ths Water in _____ Inch
 _____ /10ths Merc. in _____ Inch
 Volume _____ Cu. Ft.
 Rock Pressure _____ lbs. _____ hrs.
 Oil _____ bbls., 1st 24 hrs.
 Fresh water _____ feet _____ feet
 Salt water _____ feet _____ feet

Casing and Tubing	Used in Drilling	Left in Well	Packers
Size			Kind of Packer
16			
13			
10	50'	50'	Size of
8 1/4	516'	None	
6 3/8	1489'	1489'	Depth set
5 3/16			
3			Perf. top
2			Perf. bottom
Liners Used			Perf. top
			Perf. bottom

CASING CEMENTED _____ SIZE _____ No. Ft. _____ Date _____

COAL WAS ENCOUNTERED AT _____ FEET _____ INCHES
 _____ FEET _____ INCHES FEET _____ INCHES
 _____ FEET _____ INCHES FEET _____ INCHES

Formation	Color	Hard or Soft	Top	Bottom	Oil, Gas or Water	Depth Found	Remarks
Salt Sand			800	1295			
Maxon Sand			1390	1415			
Lt. Lime			1415	1445			
Lime			1455	1465			
Bg. Lime			1475	1610			
Keener Sand			1610	1631			
Oil Sand			1734	1754			
TOTAL DEPTH				1759			

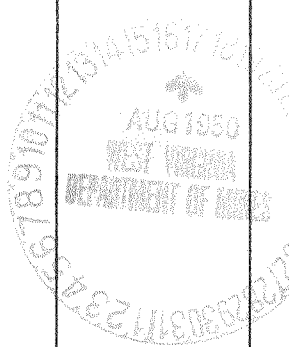

(Over)

JUN 28 1951

Person 11
Pell's on testing 9-23

Mary E. H
Canning

Offenses -

Angus - 8

20th 1912