

New Location   
 Drill Deeper   
 Abandonment

Company SAM BEREN  
 Address 516 - 4th St., MARIETTA, OHIO  
 Farm ETHEL PRICE  
 Tract \_\_\_\_\_ Acres 26 Lease No. 776  
 Well (Farm) No. 2-4 Serial No. 2863  
 Elevation (Spirit Level) SEE ABOVE  
 Quadrangle GLENDENIN  
 County KANAWHA District ELK  
 Engineer B. C. Kuhl  
 Engineer's Registration No. 9  
 File No. \_\_\_\_\_ Drawing No. \_\_\_\_\_  
 Date 9-28-49 Scale 1" - 400'

STATE OF WEST VIRGINIA  
 DEPARTMENT OF MINES  
 OIL AND GAS DIVISION  
 CHARLESTON

**WELL LOCATION MAP**

FILE NO. KAN-750-A-#2  
KAN-751-A-#4

+ Denotes location of well on United States Topographic Maps, scale 1 to 62,500, latitude and longitude lines being represented by border lines as shown.

- Denotes one inch spaces on border line of original tracing.

ETHEL PRICE NO. 2 WELL.

750A

Elk District, Kanawha County, W. Va.  
By Strauss & Beren, Marietta, Ohio.  
Abandoned under permit Kan-.....-A?  
On 26 acres, on Blue Creek.  
Elevation, 741' L.  
Coal not operated.  
Drilling commenced April 11, 1912; completed May 10, 1912.  
10" casing, 42'; 8½", 537' (pulled); 6¾", 1545'.  
Oil well. Record to Dept. of Mines stamped Aug. 17, 1950.  
Record to RCT from Mrs. Griffith Nov. 18, 1950. Old File No. 1498.

	Top.	Bottom.
Salt Sand	800	- 1372
Little Lime	1480	- 1505
Big Lime	1540	- 1697
Oil sand	1794	- 1816
Total depth		1822



1498

STATE OF WEST VIRGINIA  
DEPARTMENT OF MINES  
OIL AND GAS DIVISION

WELL RECORD

Permit No. KAN-750-A

Oil or Gas Well \_\_\_\_\_  
(KIND)


Company Strauss & Beren  
 Address Marietta, Ohio  
 Farm Ethel Price Acres 26.  
 Location (waters) Blue Creek  
 Well No. 2 Elev. 741'  
 District Elk County Kanawha  
 The surface of tract is owned in fee by \_\_\_\_\_  
 Address \_\_\_\_\_  
 Mineral rights are owned by Coal Not Operated  
 Address \_\_\_\_\_  
 Drilling commenced Apr. 11, 1912  
 Drilling completed May 10, 1912  
 Date Shot \_\_\_\_\_ From \_\_\_\_\_ To \_\_\_\_\_  
 With \_\_\_\_\_  
 Open Flow \_\_\_\_\_ /10ths Water in \_\_\_\_\_ Inch  
 \_\_\_\_\_ /10ths Merc. in \_\_\_\_\_ Inch  
 Volume \_\_\_\_\_ Cu. Ft.  
 Rock Pressure \_\_\_\_\_ lbs. \_\_\_\_\_ hrs.  
 Oil \_\_\_\_\_ bbls., 1st 24 hrs.  
 Fresh water \_\_\_\_\_ feet \_\_\_\_\_ feet  
 Salt water \_\_\_\_\_ feet \_\_\_\_\_ feet

Casing and Tubing	Used in Drilling	Left in Well	Packers
Size			Kind of Packer
16			
13			
10	42'	42'	Size of
8 1/4	537'	None	
6 5/8	1545'	1545'	Depth set
5 3/16			
3			Perf. top
2			Perf. bottom
Liners Used			Perf. top
			Perf. bottom

CASING CEMENTED \_\_\_\_\_ SIZE \_\_\_\_\_ No. Ft. \_\_\_\_\_ Date \_\_\_\_\_

COAL WAS ENCOUNTERED AT \_\_\_\_\_ FEET \_\_\_\_\_ INCHES  
 \_\_\_\_\_ FEET \_\_\_\_\_ INCHES FEET \_\_\_\_\_ INCHES  
 \_\_\_\_\_ FEET \_\_\_\_\_ INCHES FEET \_\_\_\_\_ INCHES

Formation	Color	Hard or Soft	Top	Bottom	Oil, Gas or Water	Depth Found	Remarks
Salt Sand			800	1372			
Lt. Lime			1480	1505			
Bg. Lime			1540	1697			
Oil Sand			1794	1816			
TOTAL DEPTH				1822			

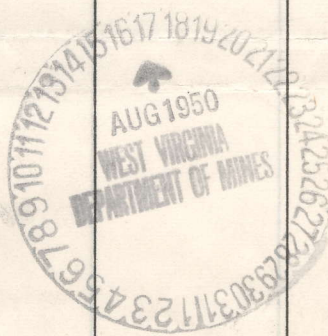

NOV 18 1950