

Latitude $38^{\circ} 25'$

Longitude $81^{\circ} 30'$

760-A	S	2.34
#34	W	1.20
764-A	S	2.01
#32	W	1.20
765-A	S	2.23
#33	W	1.27

COAL NOT OPERATED

- New Location...
- Drill Deeper.....
- Abandonment.....

Company KREBS OIL CO., INC
 Address CHAS. NATIONAL BANK BLDG.
 Farm ELK RIVER COAL CO. CHAS. W. VA
 Tract _____ Acres 1576 Lease No. 27466
 Well (Farm) No. 32-33-34 Serial No. 3371
 Elevation (Spirit Level) AS ABOVE 3630
 Quadrangle CHARLESTON
 County KANAWHA District ELK
 Engineer E. G. Krebs **EC**
 Engineer's Registration No. 773
 File No. _____ Drawing No. _____
 Date 8-23-50 Scale 1" = 1320'

STATE OF WEST VIRGINIA
 DEPARTMENT OF MINES
 OIL AND GAS DIVISION
 CHARLESTON

WELL LOCATION MAP
 FILE NO. KAN-760-A-#34
KAN-765-A-#33 KAN-764-A-#32
 + Denotes location of well on United States Topographic Maps, scale 1 to 62,500, latitude and longitude lines being represented by border lines as shown.
 - Denotes one inch spaces on border line of original tracing.

6-6 218

ELK RIVER COAL CO. NO. 33 WELL.

765A

Elk District, Kanawha County, W. Va.
 By Krebs Oil Co., Box 213, Charleston, W. Va.
 Abandoned under permit Kan-.....-A?
 On 1576 acres, on Blue Creek.
 Elevation, ' L.
 Surface owned by United Fuel Gas Co., Charleston, W. Va., and minerals
 by Preston Oil Co., Charleston, W. Va.
 Drilling commenced Aug. 6, 1920; completed Oct. 23, 1920.
 Shot Oct. 25, 1920, with 80 qts.
 8 1/4" casing, 410' (pulled); 6 5/8", 1794'.
 Oil well. Record to Dept. of Mines dated Aug. 31, 1950.
 Record to RCT from Mrs. Griffith Nov. 18, 1950. Old File No. 1484.

	Top.	Bottom.
Slate	0	50
Sand	50	100
Slate and shells	100	200
Sand	200	275
Slate and shells	275	325
Sand	325	370
Coal	370	374
Sand	374	440
Slate	440	500
Sand	500	550
Slate	550	660
Sand	660	700
Slate and shells	700	780
Salt Sand	780	1365
Slate	1365	1373
Sand	1373	1532
Little Lime	1532	1570
Pencil Cave	1570	1574
Lime shells	1574	1576
Pencil Cave	1576	1579
Big Lime	1579	1770
Slate	1770	1772
Lime	1772	1788
Big Injun Sand	1788	1825
Slate and shells	1825	1955
Weir Sand (oil, 1960-1970')	1965	2010
Total depth		2013

For plat see 760 A
lat 38° 25' S 2.23
long 81° 30' W 1.27



STATE OF WEST VIRGINIA
DEPARTMENT OF MINES
OIL AND GAS DIVISION

1484

WELL RECORD


Permit No. KAW-765-A Quad. Charleston Oil or Gas Well Oil (KIND)

Company Krebs Oil Company
Address Box 213, Charleston, W.Va.
Farm Elk River Coal Co. Acres 1576
Location (waters) Blue Creek
Well No. 33 (3629) Elev. 872
District Elk County Kanawha
The surface of tract is owned in fee by United Fuel Gas Company Address Charleston, W.Va.
Mineral rights are owned by Preston Oil Company Address Charleston, W.Va.
Drilling commenced August 6, 1920
Drilling completed October 23, 1920
Date Shot 10/25/20 From _____ To _____
With 60 Qts.
Open Flow _____ /10ths Water in _____ Inch
_____ /10ths Merc. in _____ Inch
Volume _____ Cu. Ft.
Rock Pressure _____ lbs. _____ hrs.
Oil _____ bbls., 1st 24 hrs.
Fresh water _____ feet _____ feet
Salt water _____ feet _____ feet

Casing and Tubing	Used in Drilling	Left in Well	Packers
Size			
16			Kind of Packer
13			
10			Size of
8 1/4	410'	--	
6 5/8	1794'	1794'	Depth set
5 3/16			
3			Perf. top
2			Perf. bottom
Liners Used			Perf. top
			Perf. bottom

CASING CEMENTED _____ SIZE _____ No. Ft. _____ Date _____
COAL WAS ENCOUNTERED AT _____ FEET _____ INCHES
_____ FEET _____ INCHES FEET _____ INCHES
_____ FEET _____ INCHES FEET _____ INCHES

Formation	Color	Hard or Soft	Top	Bottom	Oil, Gas or Water	Depth Found	Remarks
Slate				50			
Sand			50	100			
Slate and Shells			100	200			
Sand			200	275			
Slate and Shells			275	325			
Sand			325	370			
Coal			370	374			
Sand			374	440			
Slate			440	500			
Sand			500	550			
Slate			550	660			
Sand			660	700			
Slate and Shells			700	780			
Salt Sand			780	1365			
Slate			1365	1373			
Sand			1373	1532			
Little Lime			1532	1570			
Pencil Cave			1570	1574			
Lime Shells			1574	1576			
Pencil Cave			1576	1579			
Big Lime			1579	1770			
Slate			1770	1772			
Lime			1772	1788			
Injun Sand			1788	1825			
Slate and Shells			1825	1955			
Weir Sand			1955	2010			
Total Depth				2013'			
Oil				1960'-1970'			

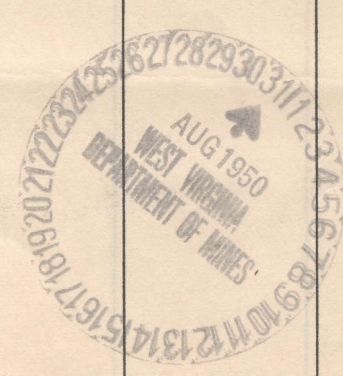

NOV 18 1950