

Company SAM BEREN  
 Address 516-4th. St., MARIETTA, OHIO  
 Farm WILLIAM YOUNG, HEIRS  
 Tract \_\_\_\_\_ Acres 51 Lease No. 27198  
 Well (Farm) No. 4 Serial No. 3157  
 Elevation (Spirit Level) 707.1  
 Quadrangle CLENDENIN  
 County KANAWHA District ELK  
 Engineer B.E. Miller  
 Engineer's Registration No. 9  
 File No. \_\_\_\_\_ Drawing No. \_\_\_\_\_  
 Date 10-4-49 Scale 1" = 400'

STATE OF WEST VIRGINIA  
 DEPARTMENT OF MINES  
 OIL AND GAS DIVISION  
 CHARLESTON

**WELL LOCATION MAP**  
 FILE NO. KAN-766-A

+ Denotes location of well on United States Topographic Maps, scale 1 to 62,500, latitude and longitude lines being represented by border lines as shown.  
 - Denotes one inch spaces on border line of original tracing.

6-0 210

WILLIAM YOUNG HEIRS NO. 4 WELL.

Elk District, Kanawha County, W. Va.  
By Strauss & Beren, Marietta, Ohio.  
Abandoned under permit Kan-.....-A?  
On 51 acres, on Blue Creek.  
Elevation, 707.1' L.

766A

Surface owned by Wm. Young Heirs, Blue Creek, W. Va.; coal not operated.  
Drilling commenced Dec. 24, 1914; completed Jan. 28, 1915.  
8 $\frac{1}{4}$ " casing, 590' (pulled); 6 $\frac{5}{8}$ ", 1345'.  
Oil well. Record to Dept. of Mines stamped Aug. 22, 1950.  
Record to RCT from Mrs. Griffith June 24, 1951. Old File No. 1552.

	Top.	Bottom.
Salt Sand	635	- 1154
Maxton Sand	1254	- 1275
Little Lime	1285	- 1317
Big Lime	1342	- 1505
Weir Sand	1548	- 1759
Total depth		1759



STATE OF WEST VIRGINIA  
DEPARTMENT OF MINES  
OIL AND GAS DIVISION

(L170)

1057

WELL RECORD

Permit No. Ab 766-A

Oil or Gas Well ~~X~~

(KIND)


Company Strauss & Beren  
 Address Marietta, Ohio  
 Farm William Young Heirs Acres 51.  
 Location (waters) Blue Creek  
 Well No. 4 Elev. 707.1  
 District Elk County Kanawha  
 The surface of tract is owned in fee by Wm. Young, Heirs  
 Address Blue Cr. W.Va.  
 Mineral rights are owned by Not Operated  
 Address \_\_\_\_\_  
 Drilling commenced Dec. 24, 1914  
 Drilling completed Jan. 28, 1915  
 Date Shot \_\_\_\_\_ From \_\_\_\_\_ To \_\_\_\_\_  
 With \_\_\_\_\_  
 Open Flow /10ths Water in \_\_\_\_\_ Inch  
 /10ths Merc. in \_\_\_\_\_ Inch  
 Volume \_\_\_\_\_ Cu. Ft.  
 Rock Pressure \_\_\_\_\_ lbs. \_\_\_\_\_ hrs.  
 Oil \_\_\_\_\_ bbls., 1st 24 hrs.  
 Fresh water \_\_\_\_\_ feet \_\_\_\_\_ feet  
 Salt water \_\_\_\_\_ feet \_\_\_\_\_ feet

Casing and Tubing	Used in Drilling	Left in Well	Packers
Size			Kind of Packer
16			
18			Size of
10			Depth set
8 1/4	590'	None	
6 3/8	1345'	1345'	
5 3/16			Perf. top
3			Perf. bottom
2			Perf. top
Liners Used			Perf. bottom

CASING CEMENTED \_\_\_\_\_ SIZE \_\_\_\_\_ No. Ft. \_\_\_\_\_ Date \_\_\_\_\_

COAL WAS ENCOUNTERED AT \_\_\_\_\_ FEET \_\_\_\_\_ INCHES  
 \_\_\_\_\_ FEET \_\_\_\_\_ INCHES \_\_\_\_\_ FEET \_\_\_\_\_ INCHES  
 \_\_\_\_\_ FEET \_\_\_\_\_ INCHES \_\_\_\_\_ FEET \_\_\_\_\_ INCHES

Formation	Color	Hard or Soft	Top	Bottom	Oil, Gas or Water	Depth Found	Remarks
Salt Sand			635	1154			
Maxon Sand			1254	1275			
Lt. Lime			1285	1317			
Bg. Lime			1342	1505			
Weir Sand			1548	1759			
TOTAL DEPTH				1759			

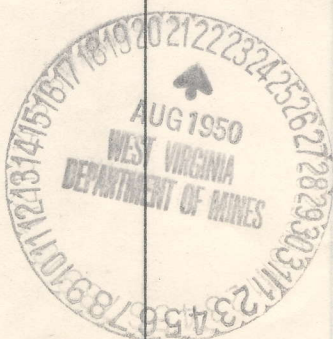

(Over)

JUN 24 1951