

New Location
 Drill Deeper
 Abandonment

Company SAM BEREN
 Address 516-4th St., MARIETTA, OHIO
 Farm G. W. BELCHER
 Tract _____ Acres 183 Lease No. 738
 Well (Farm) No. 2-4-15 Serial No. (3140)
 Elevation (Spirit Level) SEE ABOVE (3142)
 Quadrangle CLENDENIN
 County KANAWHA District ELK NW
 Engineer L. P. Kuel
 Engineer's Registration No. 9
 File No. _____ Drawing No. _____
 Date 9-12-49 Scale 1"-1320'

STATE OF WEST VIRGINIA
 DEPARTMENT OF MINES
 OIL AND GAS DIVISION
 CHARLESTON

WELL LOCATION MAP
 FILE NO. KAN-782-A-#2
KAN-783-A-#4
KAN-784-A-#15

+ Denotes location of well on United States Topographic Maps, scale 1 to 62,500, latitude and longitude lines being represented by border lines as shown.
 - Denotes one inch spaces on border line of original tracing.



STATE OF WEST VIRGINIA
DEPARTMENT OF MINES
OIL AND GAS DIVISION

1506

WELL RECORD

Permit No. Kan-782-82 Oil or Gas Well X (KIND)

Company Valley Steel Products Company
Address Saint Louis, Mo.
Farm G. W. Belcher Acres 183
Location (waters) Blue Creek
Well No. 2 (314) Elev. 960'
District Elk County Kanawha

The surface of tract is owned in fee by G. W. Belcher, Hrs
Address Blue Creek, W. Va

Mineral rights are owned by Not Operated
Address _____

Drilling commenced July 23, 1914

Drilling completed Oct. 17, 1914

Date Shot _____ From _____ To _____

With _____

Open Flow _____ /10ths Water in _____ Inch
_____ /10ths Merc. in _____ Inch

Volume _____ Cu. Ft.

Rock Pressure _____ lbs. _____ hrs.

Oil _____ bbls., 1st 24 hrs.

Fresh water _____ feet _____ feet

Salt water _____ feet _____ feet

Casing and Tubing	Used in Drilling	Left in Well	Packers
Size			Kind of Packer
16			
18			Size of
8 1/4	700'	None	
6 3/8	1602'	1602'	Depth set
5 3/16	1941'	1941'	none
3			Perf. top
2			Perf. bottom
Liners Used			Perf. top
			Perf. bottom


CASING CEMENTED _____ SIZE _____ No. Ft. _____ Date _____

COAL WAS ENCOUNTERED AT _____ FEET _____ INCHES

_____ FEET _____ INCHES _____ FEET _____ INCHES

_____ FEET _____ INCHES _____ FEET _____ INCHES

Formation	Color	Hard or Soft	Top	Bottom	Oil, Gas or Water	Depth Found	Remarks
Salt Sand			910	1410			
Maxon Sand			1507	1541			
Little Lime			1550	1586			
Pencil Cave			1599	1606			
Big Lime			1606	1752			
Weir Sand			1816	2018			
TOTAL DEPTH				2018			

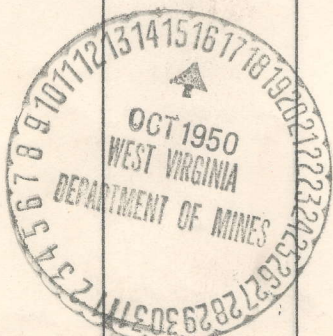

(Over)

FEB 23 1951