

Company SAM BEREN

Address 516-4th ST., MARIETTA OHIO

Farm E. ANDERSON

Tract _____ Acres 21 Lease No. 27202
27460
27477

Well (Farm) No. 2 Serial No. 3193

Elevation (Spirit Level) 859

Quadrangle CLENDENIN

County KANAWHA District ELK

Engineer B. E. Kutz

Engineer's Registration No. 9

File No. _____ Drawing No. _____

Date 10-5-49 Scale 1"-400'

STATE OF WEST VIRGINIA
DEPARTMENT OF MINES
OIL AND GAS DIVISION
CHARLESTON

WELL LOCATION MAP
FILE NO. KAN-802-A

+ Denotes location of well on United States Topographic Maps, scale 1 to 62,500, latitude and longitude lines being represented by border lines as shown.

- Denotes one inch spaces on border line of original tracing.

60 214

E. ANDERSON NO. 2 (3193) - SAM BEREN - KAN-802-A

E. ANDERSON NO. 2 WELL.

Elk District, Kanawha County, W. Va. 8024
By Valley Steel Products Co., St. Louis, Mo.
Abandoned under permit Kan-.....-A?
On 21 acres, on Blue Creek.
Elevation, 859' L.
Drilling commenced June 15, 1915; completed July 29, 1915.
Shot Aug. 2, 1915, with 60 qts.
8 $\frac{1}{4}$ " casing, 570' (pulled); 6 $\frac{5}{8}$ " , 1462'.
Coal was encountered at 572-576'.
Oil well. Record to Dept. of Mines stamped Dec. 22, 1950.
Record to RCT from Mrs. Griffith June 24, 1951. Old File No. 1534.

	Top.	Bottom.
Coal	572	- 576
Salt Sand	780	- 1247
Maxton Sand	1375	- 1396
Little Lime	1403	- 1436
Pencil Cave	1455	- 1461
Big Lime	1461	- 1602
Weir Sand	1675	- 1874
Total depth		1877



STATE OF WEST VIRGINIA
DEPARTMENT OF MINES
OIL AND GAS DIVISION

1534

WELL RECORD

Permit No. 802-A Oil or Gas Well _____ (KIND)


Company valley Steel Products Company
 Address Saint Louis, Mo.
 Farm B. Anderson Acres 21
 Location (waters) Blue Creek
 Well No. 2 Elev. 850'
 District Elk County Kanawha
 The surface of tract is owned in fee by _____
 Address _____
 Mineral rights are owned by Coal Not Operated
 Address _____
 Drilling commenced June 15, 1915
 Drilling completed July 29, 1915
 Date Shot 8-2-15 From _____ To _____
 With 60qts.
 Open Flow _____ /10ths Water in _____ Inch
 _____ /10ths Merc. in _____ Inch
 Volume _____ Cu. Ft.
 Rock Pressure _____ lbs. _____ hrs.
 Oil _____ bbls., 1st 24 hrs.
 Fresh water _____ feet _____ feet
 Salt water _____ feet _____ feet

Casing and Tubing	Used in Drilling	Left in Well	Packers
Size			
16			Kind of Packer _____
13			
10			Size of _____
8 1/4	570'	None	
6 1/2	1462'	1462'	Depth set _____
5 3/16			
3			Perf. top _____
2			Perf. bottom _____
Liners Used			Perf. top _____
			Perf. bottom _____

CASING CEMENTED _____ SIZE _____ No. Ft. _____ Date _____

COAL WAS ENCOUNTERED AT 572 FEET _____ INCHES
 _____ FEET _____ INCHES FEET _____ INCHES
 _____ FEET _____ INCHES FEET _____ INCHES

Formation	Color	Hard or Soft	Top	Bottom	Oil, Gas or Water	Depth Found	Remarks
Coal			572	576			
Salt Sand			780	1247			
Maxon Sand			1375	1396			
Little Lime			1403	1436			
Pencil Cave			1455	1461			
Big Lime			1461	1602			
Weir Sand			1675	1874			
TOTAL DEPTH				1877			

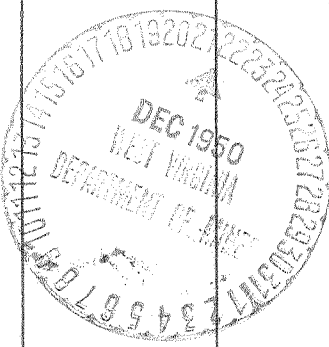

JUN 24 1951