

Company SAM BEREN
 Address 516-4th. ST., MARIETTA, OHIO
 Farm E. ANDERSON HRS.
 Tract _____ Acres 100 Lease No. 27199
 Well (Farm) No. 5-8 Serial No. 3159
 Elevation (Spirit Level) SEE ABOVE 3395
 Quadrangle CLENDENIN
 County KANAWHA District ELK
 Engineer B. E. ...
 Engineer's Registration No. 9
 File No. _____ Drawing No. _____
 Date 9-28-49 Scale 1"-400'

STATE OF WEST VIRGINIA
 DEPARTMENT OF MINES
 OIL AND GAS DIVISION
 CHARLESTON

WELL LOCATION MAP
 FILE NO. KAN-803-A-#5
KAN-804-A-#8

+ Denotes location of well on United States Topographic Maps, scale 1 to 62,500, latitude and longitude lines being represented by border lines as shown.

- Denotes one inch spaces on border line of original tracing.

6-0 218

E. ANDERSON HRS. MS. 5 & 8 - SAM BEREN - KAN-803-A-A

G. ANDERSON HEIRS NO. 5 WELL.

8030

Elk District, Kanawha County, W. Va.

By Valley Steel Products Co., St. Louis, Mo.

Abandoned under permit Kan-.....-A7

On 100 acres, on Blue Creek.

Elevation, 1095' L.

Drilling commenced Jan. 13, 1915; completed March 2, 1915.

8 $\frac{1}{2}$ " casing, 683' (pulled); 6 $\frac{3}{8}$ " 1713'; 5 $\frac{1}{8}$ " 2044'; all left in.

Coal was encountered at 528-532'.

Oil well. Record to Dept. of Mines stamped Dec. 22, 1950.

Record to ROT from Mrs. Griffith June 24, 1951. Old File No. 1535.

	Top.	Bottom.
Coal	528	- 532
Salt Sand	995	- 1495
Maxton Sand	1625	- 1643
Little Line	1645	- 1678
Big Line	1710	- 1870
Weir Sand	1928	-
Total depth		2131



STATE OF WEST VIRGINIA
DEPARTMENT OF MINES
OIL AND GAS DIVISION

1535

Ab 803-A

WELL RECORD


Permit No. _____ Oil or Gas Well _____ (KIND)

Company Valley Steel Products Company
 Address Saint Louis, Mo.
 Farm G. Anderson Heirs Acres 100
 Location (waters) Blue Creek
 Well No. 5 Elev. 1095'
 District Elk County Kanawha
 The surface of tract is owned in fee by _____
 Address _____
 Mineral rights are owned by Coal Not Operated
 Address _____
 Drilling commenced Jan. 13, 1915
 Drilling completed Mar. 2, 1915
 Date Shot _____ From _____ To _____
 With _____
 Open Flow _____ /10ths Water in _____ Inch
 _____ /10ths Merc. in _____ Inch
 Volume _____ Cu. Ft.
 Rock Pressure _____ lbs. _____ hrs.
 Oil _____ bbls., 1st 24 hrs.
 Fresh water _____ feet _____ feet
 Salt water _____ feet _____ feet

Casing and Tubing	Used in Drilling	Left in Well	Packers
Size			
16			Kind of Packer _____
13			
10			Size of _____
8 1/4	683'	None	
6 5/8	1713'	1713'	Depth set _____
5 3/16	2044'	2044'	
3			Perf. top _____
2			Perf. bottom _____
Liners Used			Perf. top _____
			Perf. bottom _____

CASING CEMENTED _____ SIZE _____ No. Ft. _____ Date _____
 COAL WAS ENCOUNTERED AT 528 FEET _____ INCHES
 _____ FEET _____ INCHES FEET _____ INCHES
 _____ FEET _____ INCHES FEET _____ INCHES

Formation	Color	Hard or Soft	Top	Bottom	Oil, Gas or Water	Depth Found	Remarks
Coal			528	532			
Salt Sand			995	1495			
Maxon Sand			1625	1643			
Little Lime			1645	1678			
Big Lime			1710	1870			
Weir Sand			1928				
TOTAL DEPTH				2131			

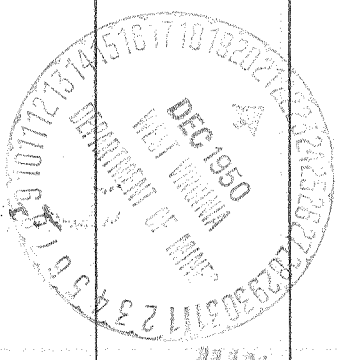

JUN 24 1951