

New Location
 Drill Deeper
 Abandonment

Company SAM BEREN (Valley Head Products & Records)
 Address 516-4th St., Marietta, Ohio
 Farm G.W. BELCHER
 Tract _____ Acres 183 Lease No. 738
 Well (Farm) No. 6-8-9 Serial No. 3201
 Elevation (Spirit Level) SEE ABOVE 3225
 Quadrangle CLENDENIN
 County KANAWHA District ELK
 Engineer B.E. Keels
 Engineer's Registration No. 9
 File No. _____ Drawing No. _____
 Date 9-12-49 Scale 1" = 1320'

STATE OF WEST VIRGINIA
 DEPARTMENT OF MINES
 OIL AND GAS DIVISION
 CHARLESTON

WELL LOCATION MAP
 FILE NO. KAN-806-A-#6
KAN-807-A-#8
KAN-808-A-#9

+ Denotes location of well on United States Topographic Maps, scale 1 to 62,500, latitude and longitude lines being represented by border lines as shown.
 - Denotes one inch spaces on border line of original tracing.

6-0.217

G.W. BELCHER MS. } 6 (3201)
 } 8 (3204)
 } 9 (3225) — SAM BEREN (Valley Head Products & Records) — KAN-806-7-8-A

G. W. BELCHER NO. 6 WELL.

866A

Elk District, Kanawha County, W. Va.
By Valley Steel Products Co., St. Louis, Mo.

Abandoned under permit Kan-.....-A?

On 183 acres, on Threemile Creek.

Elevation, 1110' L.

Surface owned by G. W. Belcher Heirs, Blue Creek, W. Va.; coal not operated.

Drilling commenced July 31, 1915; completed Sept. 25, 1915.

Shot Sept. 28, 1915, with 100 qts.

8 $\frac{1}{2}$ " casing, 760' (pulled); 6 $\frac{5}{8}$ " , 1755'.

Oil well. Record to Dept. of Mines stamped Jan. 10, 1951.

Record to RCT from Mrs. Griffith June 24, 1951. Old File No. 1539.

	Top.	Bottom.
Salt Sand	1015	- 1530
Maxton Sand	1650	- 1668
Little Lime	1690	- 1723
Big Lime	1750	- 1895
Weir Sand	1965	- 2159
Total depth		2164



STATE OF WEST VIRGINIA
DEPARTMENT OF MINES
OIL AND GAS DIVISION

1539

WELL RECORD

Permit No. KAN-800-A

Oil or Gas Well _____
(KIND)


Company Valley Steel Products Company
Address Saint Louis, Mo.
Farm G. W. Belcher Acres 183
Location (waters) Three Mile
Well No. 6 Elev. 1110'
District Elk County Kanawha
The surface of tract is owned in fee by G.W. Belcher Hrs.
Address Blue Creek, W.Va.

Casing and Tubing	Used in Drilling	Left in Well	Packers
Size			
16			Kind of Packer
13			
10			Size of
8 1/4	760'	None	
6 1/2	1755'	1755'	Depth set
5 3/16			
3			Perf. top
2			Perf. bottom
Liners Used			Perf. top
			Perf. bottom

Mineral rights are owned by Coal Not Operated
Address _____
Drilling commenced July 31, 1915
Drilling completed Sept. 25, 1915
Date Shot 9-28-15 From _____ To _____
With 100qts.
Open Flow _____ /10ths Water in _____ Inch
_____ /10ths Merc. in _____ Inch
Volume _____ Cu. Ft.
Rock Pressure _____ lbs. _____ hrs.
Oil _____ bbls., 1st 24 hrs.
Fresh water _____ feet _____ feet
Salt water _____ feet _____ feet

CASING CEMENTED _____ SIZE _____ No. Ft. _____ Date _____
COAL WAS ENCOUNTERED AT _____ FEET _____ INCHES
_____ FEET _____ INCHES _____ FEET _____ INCHES
_____ FEET _____ INCHES _____ FEET _____ INCHES

Formation	Color	Hard or Soft	Top	Bottom	Oil, Gas or Water	Depth Found	Remarks
Salt Sand			1015	1530			
Maxon Sand			1650	1668			
Little Lime			1690	1723			
Big Lime			1750	1895			
Weir Sand			1965	2159			
TOTAL DEPTH:				2164			

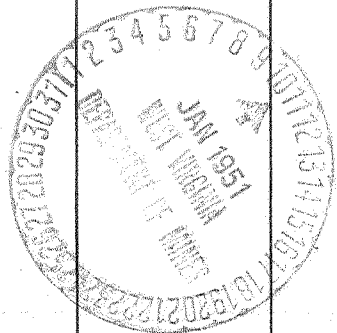

JUN 24 1951