

New Location   
 Drill Deeper   
 Abandonment

Company SAM BEREN  
 Address 516 - 4th St. MARIETTA, OHIO  
 Farm M. & N. VAN CAMP  
 Tract \_\_\_\_\_ Acres 116 Lease No. 797  
 Well (Farm) No. 1-2-4 Serial No. 290  
3282  
 Elevation (Spirit Level) SEE ABOVE  
 Quadrangle CLENDENIN  
 County KANAWHA District ELK  
 Engineer G. E. Melz  
 Engineer's Registration No. 9  
 File No. \_\_\_\_\_ Drawing No. \_\_\_\_\_  
 Date 9-26-49 Scale 1"-400'

STATE OF WEST VIRGINIA  
 DEPARTMENT OF MINES  
 OIL AND GAS DIVISION  
 CHARLESTON

WELL LOCATION MAP

FILE NO. KAN-816-A-#1  
KAN-817-A-#2  
KAN-818-A-#4

+ Denotes location of well on United States Topographic Maps, scale 1 to 62,500, latitude and longitude lines being represented by border lines as shown.

- Denotes one inch spaces on border line of original tracing.

6-0 217

M. & N. Van Camp (No. 1 790) (No. 2 3282) (No. 3 3284) - SAM BEREN (Full Oil Products Co. - Round) - KAN-816-17-18-A

M. AND N. VANCAMP NO. 1 WELL.

Elk District, Kanawha County, W. Va.  
By Valley Steel Products Co., St. Louis, Mo.  
Abandoned under permit Kan-.....-A?  
On 116 acres, on Threemile Creek.  
Elevation, 923' L.  
Coal not operated.  
Drilling commenced Feb. 2, 1911; completed April ..., 1911.  
Shot with 50 qts.  
13" casing, 16'; 8 $\frac{1}{4}$ "", 750' (stricken out by pen); 6 $\frac{5}{8}$ "", 1612'.  
Gas well. Record to Dept. of Mines stamped ~~1911~~ 1951.  
Record to RCT from Mrs. Griffith Aug. 17, 1951. Old File No. 1577.

	Top.	Bottom.
Salt Sand	900	- 1200
Little Lime	1570	- 1600
Pencil Cave	1600	- 1607
Big Lime	1612	- 1787
Big Injun Sand	1787	- 1892
Total depth		1964



STATE OF WEST VIRGINIA  
DEPARTMENT OF MINES  
OIL AND GAS DIVISION

1577

WELL RECORD

Permit No. KAN-816-A


Oil or Gas Well \_\_\_\_\_  
(KIND)

Company Valley Steel Products Company  
 Address Saint Louis, Mo.  
 Farm M. & N. VanCamp Acres 116  
 Location (waters) Three Mile  
 Well No. 1 Elev. 923'  
 District Elk County Kanawha  
 The surface of tract is owned in fee by \_\_\_\_\_  
 Address \_\_\_\_\_  
 Mineral rights are owned by Coal Not Operated  
 Address \_\_\_\_\_  
 Drilling commenced Feb. 2, 1911  
 Drilling completed April 1911  
 Date Shot From \_\_\_\_\_ To \_\_\_\_\_  
 With 50qts.  
 Open Flow /10ths Water in \_\_\_\_\_ Inch  
 /10ths Merc. in \_\_\_\_\_ Inch  
 Volume \_\_\_\_\_ Cu. Ft.  
 Rock Pressure \_\_\_\_\_ lbs. \_\_\_\_\_ hrs.  
 Oil \_\_\_\_\_ bbls., 1st 24 hrs.  
 Fresh water \_\_\_\_\_ feet \_\_\_\_\_ feet  
 Salt water \_\_\_\_\_ feet \_\_\_\_\_ feet

Casing and Tubing	Used in Drilling	Left in Well	Packers
Size			Kind of Packer
16			
13	16'	16'	
10			Size of
8 1/4	750'	750'	
6 5/8	1612'	1612'	Depth set
5 3/16			
3			Perf. top
2			Perf. bottom
Liners Used			Perf. top
			Perf. bottom

CASING CEMENTED \_\_\_\_\_ SIZE \_\_\_\_\_ No. Ft. \_\_\_\_\_ Date \_\_\_\_\_  
 COAL WAS ENCOUNTERED AT \_\_\_\_\_ FEET \_\_\_\_\_ INCHES  
 \_\_\_\_\_ FEET \_\_\_\_\_ INCHES FEET \_\_\_\_\_ INCHES  
 \_\_\_\_\_ FEET \_\_\_\_\_ INCHES FEET \_\_\_\_\_ INCHES

Formation	Color	Hard or Soft	Top	Bottom	Oil, Gas or Water	Depth Found	Remarks
Salt Sand			900	1200			
Lt. Lime			1570	1600			
Pencil Cave			1600	1607			
Big Lime			1612	1787			
Injun Sand			1787	1792			
TOTAL DEPTH				<del>1792</del> 1964			

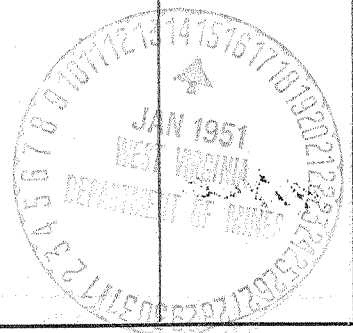

(Over) AUG 17 1951