

New Location
 Drill Deeper
 Abandonment

Company SAM BEREN (Glenwood Products - Rowland)
 Address 516 - 4th St. MARIETTA, OHIO
 Farm M. & N. VAN CAMP
 Tract _____ Acres 116 Lease No. 797
 Well (Farm) No. 1-2-4 Serial No. 290
3282
 Elevation (Spirit Level) SEE ABOVE
 Quadrangle CLENDENIN
 County KANAWHA District ELK
 Engineer G. E. Melz
 Engineer's Registration No. 9
 File No. _____ Drawing No. _____
 Date 9-26-49 Scale 1" - 400'

STATE OF WEST VIRGINIA
 DEPARTMENT OF MINES
 OIL AND GAS DIVISION
 CHARLESTON

WELL LOCATION MAP
 FILE NO. KAN-816-A-#1
KAN-817-A-#2
KAN-818-A-#4

+ Denotes location of well on United States Topographic Maps, scale 1 to 62,500, latitude and longitude lines being represented by border lines as shown.

- Denotes one inch spaces on border line of original tracing.

6-0 217

IMPERIAL TRACING CLOTH
 M. & N. VAN CAMP (No. 1 290, No. 2 3282, No. 3 3284) - SAM BEREN (Glenwood Products - Rowland) - KAN-816-17-18-A

M. AND N. VANCAMP NO. 2 WELL.

817A

Elk District, Kanawha County, W. Va.
By Valley Steel Products Co., St. Louis, Mo.
Abandoned under permit Kan-.....-A?
On 116 acres, on Threemile Creek.
Elevation, 938' L.
Coal not operated.
Drilling commenced Aug. 2, 1916; completed Sept. 15, 1916.
Shot Sept. 18, 1915, with 180 qts.
8 $\frac{1}{4}$ " casing, 640' (pulled); 6 $\frac{5}{8}$ " , 1613'.
Coal was encountered at 420-421'.
Oil well. Record to Dept. of Mines stamped Jan. 15, 1951.
Record to RGT from Mrs. Griffith June 24, 1951. Old File No. 1547.

	Top.	Bottom.
Coal	420	- 421
Salt Sand	900	- 1415
Mexton Sand	1535	- 1550
Little Lime	1560	- 1585
Pencil Cave	1605	- 1612
Big Lime	1612	- 1767
Squaw Sand	1795	- 1835
Weir Sand	1938	- 2027
Total depth		2031



STATE OF WEST VIRGINIA
DEPARTMENT OF MINES
OIL AND GAS DIVISION

1547

WELL RECORD

Permit No. KAN-817-A


Oil or Gas Well _____ (KIND)

Company Valley Steel Products Company
 Address Saint Louis, Mo.
 Farm M. & N. VanCamp Acres 116
 Location (waters) Three Mile
 Well No. 2 Elev. 938'
 District Elk County Kanawha
 The surface of tract is owned in fee by _____
 Address _____
 Mineral rights are owned by Coal Not Operated
 Address _____
 Drilling commenced Aug. 2, 1916
 Drilling completed Sep. 15, 1916
 Date Shot 9-18-16 From _____ To _____
 With 180qts.
 Open Flow _____ /10ths Water in _____ Inch
 _____ /10ths Merc. in _____ Inch
 Volume _____ Cu. Ft.
 Rock Pressure _____ lbs. _____ hrs.
 Oil _____ bbls., 1st 24 hrs.
 Fresh water _____ feet _____ feet
 Salt water _____ feet _____ feet

Casing and Tubing	Used in Drilling	Left in Well	Packers
Size			
16			Kind of Packer
13			
10			Size of
8 1/4	<u>640'</u>	<u>None</u>	
6 3/4	<u>1613'</u>	<u>1613'</u>	Depth set
5 3/16			
3			Perf. top
2			Perf. bottom
Liners Used			Perf. top
			Perf. bottom

CASING CEMENTED _____ SIZE _____ No. Ft. _____ Date _____
 COAL WAS ENCOUNTERED AT 420' FEET _____ INCHES
 _____ FEET _____ INCHES FEET _____ INCHES
 _____ FEET _____ INCHES FEET _____ INCHES

Formation	Color	Hard or Soft	Top	Bottom	Oil, Gas or Water	Depth Found	Remarks
Coal			420	421			
Salt Sand			900	1415			
Maxon Sand			1535	1550			
Little Lime			1560	1585			
Pencil Cave			1605	1612			
Big Lime			1612	1767			
Squaw Sand			1795	1835			
Weir Sand			1938	2027			
TOTAL DEPTH				2031			

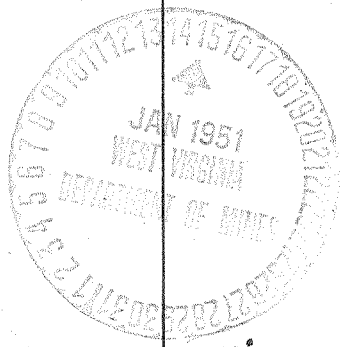

JUN 24 1951