

COAL NOT OPERATED

New Location...
 Drill Deeper...
 Abandonment...

Company SAM BEREN
 Address 516-4th St., MARIETTA, OHIO
 Farm J. F. MYERS (MARY F.)
 Tract _____ Acres 74 Lease No. 741
 Well (Farm) No. 1 Serial No. 3250
 Elevation (Spirit Level) 1174'
 Quadrangle CLENDENIN
 County KANAWHA District ELK
 Engineer B. E. Melz
 Engineer's Registration No. 9
 File No. _____ Drawing No. _____
 Date 9-29-49 Scale 1" - 400'

STATE OF WEST VIRGINIA
 DEPARTMENT OF MINES
 OIL AND GAS DIVISION
 CHARLESTON

WELL LOCATION MAP
 FILE NO. KAN-819-A

+ Denotes location of well on United States Topographic Maps, scale 1 to 62,500, latitude and longitude lines being represented by border lines as shown.
 - Denotes one inch spaces on border line of original tracing.

1.62 W
 5.42

MARY F. MYERS NO. 1 WELL.

244

Elk District, Kanawha County, W. Va.
By Valley Steel Products Co., St. Louis, Mo.
Abandoned under permit Kan-.....-47
On 7 $\frac{1}{4}$ acres, on Threemile Creek.
Elevation, 1174' L.
Coal not operated.
Drilling commenced March 7, 1916; completed April 27, 1916.
Shot May 2, 1916.
8" casing, 645' (pulled); 6 $\frac{3}{8}$ " 1865'.
Oil well. Record to Dept. of Mines stamped Jan. 15, 1951.
Record to ROT from Mrs. Griffith June 28, 1951. Old File No. 1556.

	Top.	Bottom.
Salt Sand	1000	- 1060
Salt Sand	1200	- 1660
Little Lime	1795	- 1840
Big Lime	1860	- 2025
Weir Sand	2175	- 2266
Total depth		2268



1556

STATE OF WEST VIRGINIA
DEPARTMENT OF MINES
OIL AND GAS DIVISION

WELL RECORD

Permit No. KAN-819-A

Oil or Gas Well _____
(KIND)


Company Valley Steel Products Company
 Address Saint Louis, Mo.
 Farm Mary F. Myers Acres 74
 Location (waters) Three Mile
 Well No. 1 Elev. 1174'
 District Elk County Kanawha
 The surface of tract is owned in fee by _____
 Address _____
 Mineral rights are owned by Coal Not Operated
 Address _____
 Drilling commenced Mar. 7, 1916
 Drilling completed Apr. 27, 1916
 Date Shot 5-2-16 From _____ To _____
 With _____
 Open Flow _____ /10ths Water in _____ Inch
 _____ /10ths Merc. in _____ Inch
 Volume _____ Cu. Ft.
 Rock Pressure _____ lbs. _____ hrs.
 Oil _____ bbls., 1st 24 hrs.
 Fresh water _____ feet _____ feet
 Salt water _____ feet _____ feet

Casing and Tubing	Used in Drilling	Left in Well	Packers
Size			
16			Kind of Packer
13			
10			Size of
8 1/4	645'	None	
6 3/4	1865'	1865'	Depth set
5 3/16			
3			Perf. top
2			Perf. bottom
Liners Used			Perf. top
			Perf. bottom

CASING CEMENTED _____ SIZE _____ No. Ft. _____ Date _____

COAL WAS ENCOUNTERED AT _____ FEET _____ INCHES
 _____ FEET _____ INCHES _____ FEET _____ INCHES
 _____ FEET _____ INCHES _____ FEET _____ INCHES

Formation	Color	Hard or Soft	Top	Bottom	Oil, Gas or Water	Depth Found	Remarks
Salt Sand			1000	1060			
Salt Sand			1200	1660			
Lt. Lime			1795	1840			
Big Lime			1860	2025			
Weir Sand			2175	2266			
TOTAL DEPTH				2268			

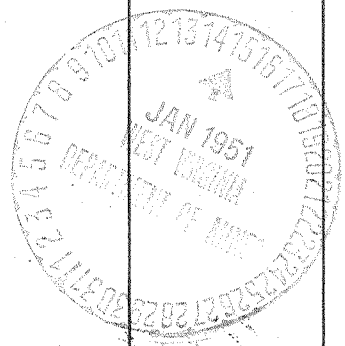

JUN 28 1951