

New Location...
 Drill Deeper...
 Abandonment...

Company KOONTZ & OSBORNE
 Address CLENDENIN, W. VA.
 Farm D.C. TAYLOR (NORA TAYLOR)
 Tract _____ Acres 2 3/4 Lease No. _____
 Well (Farm) No. 1 & 2 Serial No. F-2526
F-2936
 Elevation (Spirit Level) #1-788'; #2-646'
 Quadrangle WALTON & CLENDENIN
 County KANAWHA District BIG SANDY
 Engineer PAUL E. JOACHIM
 Engineer's Registration No. 669
 File No. 76-69 Drawing No. _____
 Date MARCH 11, 1951 Scale 1" = 400'

STATE OF WEST VIRGINIA
 DEPARTMENT OF MINES
 OIL AND GAS DIVISION
 CHARLESTON

WELL LOCATION MAP

FILE NO. KAN-825-A-#1
KAN-826-A-#2

+ Denotes location of well on United States Topographic Maps, scale 1 to 62,500, latitude and longitude lines being represented by border lines as shown.

- Denotes one inch spaces on border line of original tracing.

"IMPERIAL" TRACING CLOTH
 K & E CO., N. Y.

Handwritten notes: No. 1 (F-7526) KOONTZ & OSBORNE
 D.C. (NORA) TAYLOR No. 2 (F-2936) - (Creeley Steel Products Co. records) - KAN-825-76-A

8255

Big Sandy District, Kanawha County, W. Va.
 By Valley Steel Products Co., St. Louis, Mo.
 Abandoned under permit Kan-.....-A?
 On 2 $\frac{3}{4}$ acres, on Little Thoroughfare Run.
 Elevation, 646' L.
 Completed in 1920 (Deepening); date of originally drilling not given.
 Volume, 44/10 W. in 2".
 Rock pressure, 150 lbs. in 60 min.
 10" casing, 10'; 6 $\frac{5}{8}$ ", 1362'; 3" tubing, 1750' 10".
 Gas well. Record to Dept. of Mines stamped Mar. 20, 1951.
 Record to RCT from Mrs. Griffith Aug. 17, 1951. Old File No. 1575.

	Top.	Bottom.
Conductor	0	10
Sand	10	100
Slate	100	150
Sand	150	250
Slate	250	300
Sand	300	400
Slate and shells	400	700
Gas Sand	700	740
Slate	740	750
Salt Sand (water, 860')	750	1130
Slate and shells	1130	1200
Maxton Sand	1200	1310
Slate	1310	1312
Little Lime	1312	1354
Pencil Cave	1354	1358
Big Lime (gas, 1422')	1358	1487
Big Injun Sand (gas, 1503-1520')	1487	1527
Total depth		1527
DRILLED DEEPER ^{October} (in 1920):		
Slate and shells	1527	1585
Squaw Sand (small show of oil, 1590')	1585	1615
Slate and shells	1615	1717
Weir Sand (small show of oil, 1717-1719')	1717	1719
Black lime and slate	1719	1737
Total depth		1737



STATE OF WEST VIRGINIA
DEPARTMENT OF MINES
OIL AND GAS DIVISION

1575

WELL RECORD

Permit No. KAN-825-A

Oil or Gas Well _____
(KIND)


Company Valley Steel Products Company
 Address St. Louis, Mo.
 Farm Nora Taylor Acres 2-3/4
 Location (waters) Little Thoroughfare Run
 Well No. 2 Elev. 616.1
 District Big Sandy County Xenawha
 The surface of tract is owned in fee by _____
 Address _____
 Mineral rights are owned by _____
 Address _____
 Drilling commenced _____
 Drilling completed 1920
 Date Shot _____ From _____ To _____
 With _____

Casing and Tubing	Used in Drilling	Left in Well	Packers
Size			Kind of Packer
16			
18			
10	10'	10'	Size of
8 1/2			
6 5/8	1502	1502	Depth set
5 3/16			
3	1750' 10"	1750' 10"	Perf. top
2			Perf. bottom
Liners Used			Perf. top
			Perf. bottom

Open Flow _____ /10ths Water in _____ Inch
 _____ /10ths Merc. in _____ Inch
 Volume 44/10 _____ Cu. Ft.
 Rock Pressure 1207 in 60 min. _____ lbs. _____ hrs.
 Oil _____ bbls., 1st 24 hrs.
 Fresh water _____ feet _____ feet
 Salt water _____ feet _____ feet

CASING CEMENTED _____ SIZE _____ No. Ft. _____ Date _____
 COAL WAS ENCOUNTERED AT _____ FEET _____ INCHES
 _____ FEET _____ INCHES _____ FEET _____ INCHES
 _____ FEET _____ INCHES _____ FEET _____ INCHES

Formation	Color	Hard or Soft	Top	Bottom	Oil, Gas or Water	Depth Found	Remarks
Conductor				10			
Sand			10	100			
Slate			100	150			
Sand			150	250			
Slate			250	300			
Sand			300	400			
Slate & Shells			400	700			
Gas Sand			700	740			
Slate			740	750			
Salt Sand			750	1130			
Slate & shells			1130	1200	Water 860'		
Maxon Sand			1200	1510			
Slate			1510	1512			
Little Lime			1512	1554			
Pencil Cave			1554	1558			
Big Lime			1558	1487	Gas 1422		
Big Injun Sand			1487	1527	Gas 1503 to 1520		
Slate & Shells			1527	1585			
Squaw Sand			1585	1615	Small show of oil 1590		
Slate & shells			1615	1717			
Weir Sand			1717	1719	Small show oil, 1717 - 1719		
Black Lime & slate			1719	1737			
Total Depth				1737	Drilled well deeper October 1920 from a depth of 1527 to 1737'		

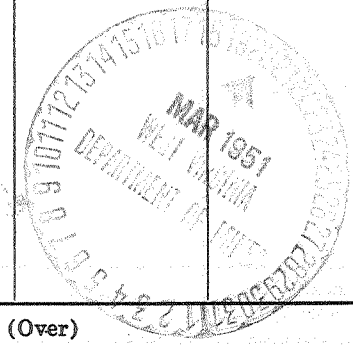

(Over)

AUG 17 1951