

Company KOONTZ & OSBORNE *(Allen Paul Products Co. Record)*

Address CLENDENIN, W. VA.

Farm W. D. ROUSH

Tract Acres 1st 89rd Lease No. \_\_\_\_\_

Well (Farm) No. 1 Serial No. F-5891

Elevation (Spirit Level) 624.7

Quadrangle CLENDENIN

County KANAWHA District BIG SANDY

Engineer PAUL E. JOACHIM

Engineer's Registration No. 669

File No. 78-67 Drawing No. \_\_\_\_\_

Date MARCH 11, 1951 Scale 1"=80'

STATE OF WEST VIRGINIA  
DEPARTMENT OF MINES  
OIL AND GAS DIVISION  
CHARLESTON

**WELL LOCATION MAP**  
FILE NO. KAN-829-A

+ Denotes location of well on United States Topographic Maps, scale 1 to 62,500, latitude and longitude lines being represented by border lines as shown.

- Denotes one inch spaces on border line of original tracing.

*6-0220*

IMPERIAL TRADING CLOTH  
K & S CO., N. Y.

*W.D. ROUSH No. 1 (F-5891) - (Allen Paul Products Co. Record) - KAN-829-A*

W. D. ROUSH NO. 1 WELL.

Big Sandy District, Kanawha County, W. Va.

By Valley Steel Products Co., St. Louis, Mo. (Formerly Keontz & Osborne well).

Abandoned under permit Kan-.....-A? (Operator)

On.....acres, 100 feet west of mouth of Birch Creek in east Clendenin.

Drilling commenced March 28, 1924; completed May 9, 1924.

Elevation, 624.7' L.

10" casing, 62'; 8 $\frac{1}{4}$ ", 300'; 6 $\frac{5}{8}$ ", 1297'; all left in.

Gas well. Record to Dept. of Mines stamped March 21, 1951.

Record to RCT from Mrs. Griffith June 28, 1951. Old File No. 1560.

	Top.	Bottom.
Sand and gravel	0	75
Slate and shell	75	375
Sand	375	400
Slate	400	465
Sand	465	525
Slate and shell	525	745
Salt Sand	745	900
Slate	900	1020
Black lime	1020	1090
Maxton Sand	1090	1240
Little Lime	1240	1274
Sand and shell	1274	1282
Slate	1282	1287
Sand and shell	1287	1293
Pencil Cave	1293	1296
Big Lime (gas, 1374')		
Big Injun Sand	1210	1448
Red lime	1448	1469
Slate and shell	1469	1502
Weir Sand (gas, 1510'; gas, 1610'; gas, 1647') (shut in May 9, 1924)	1502	1654
Slate	1654	1661
Total depth		1661



STATE OF WEST VIRGINIA  
DEPARTMENT OF MINES  
OIL AND GAS DIVISION

1560

Formerly, Koontz & Osborne

WELL RECORD

Permit No. KAW-829-A


Oil or Gas Well (KIND)

Company Valley Steel Products Company  
 Address St. Louis, Mo.  
 Farm W. D. Rough Acres \_\_\_\_\_  
 Location (waters) 100 Ft. West of mouth of Birch Crk in E. Clendenin  
 Well No. 3 Elev. 624.7'  
 District Big Sandy County Kanawha  
 The surface of tract is owned in fee by \_\_\_\_\_  
 Address \_\_\_\_\_  
 Mineral rights are owned by \_\_\_\_\_  
 Address \_\_\_\_\_  
 Drilling commenced March 23, 1924  
 Drilling completed May 9, 1924  
 Date Shot \_\_\_\_\_ From \_\_\_\_\_ To \_\_\_\_\_  
 With \_\_\_\_\_  
 Open Flow \_\_\_\_\_ /10ths Water in \_\_\_\_\_ Inch  
 \_\_\_\_\_ /10ths Merc. in \_\_\_\_\_ Inch  
 Volume \_\_\_\_\_ Cu. Ft.  
 Rock Pressure \_\_\_\_\_ lbs. \_\_\_\_\_ hrs.  
 Oil \_\_\_\_\_ bbls., 1st 24 hrs.  
 Fresh water \_\_\_\_\_ feet \_\_\_\_\_ feet  
 Salt water \_\_\_\_\_ feet \_\_\_\_\_ feet

Casing and Tubing	Used in Drilling	Left in Well	Packers
Size			Kind of Packer
16			
13			
10	62'	62'	Size of
8 3/4	300'	300'	
6 5/8	1297'	1297'	Depth set
5 3/16			
3			Perf. top
2			Perf. bottom
Liners Used			Perf. top
			Perf. bottom

CASING CEMENTED \_\_\_\_\_ SIZE \_\_\_\_\_ No. Ft. \_\_\_\_\_ Date \_\_\_\_\_  
 COAL WAS ENCOUNTERED AT \_\_\_\_\_ FEET \_\_\_\_\_ INCHES  
 \_\_\_\_\_ FEET \_\_\_\_\_ INCHES FEET \_\_\_\_\_ INCHES  
 \_\_\_\_\_ FEET \_\_\_\_\_ INCHES FEET \_\_\_\_\_ INCHES

Formation	Color	Hard or Soft	Top	Bottom	Oil, Gas or Water	Depth Found	Remarks
Sand & Gravel			0	75			
Slate & shell			75	375			
Sand			375	400			
Slate			400	465			
Sand			465	525			
Slate & shell			525	745			
Salt Sand			745	900			
Slate			900	1020			
Black Lime			1020	1090			
Waxon Sand			1090	1240			
Little Lime			1240	1274			
Sand & Shell			1274	1282			
Slate			1282	1287			
Sand & Shell			1287	1293			
Pencil Cave			1293	1296			
Big Lime			1296	1410			
Big Injun			1410	1448			
Red Lime			1448	1469			
Slate & Shell			1469	1502			
Weir Sand			1502	1654			
Slate			1654	1661			
Total Depth				1661'			
					Gas in Big Line, 1374 First Gas in Weir, 1510 2nd Gas in Weir, 1610 3rd Gas in Weir, 1647' shut in May 9, 1924		

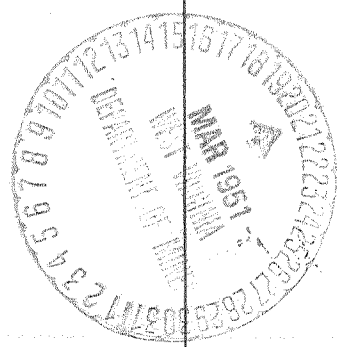

(Over) JUN 28 1951