





STATE OF WEST VIRGINIA  
DEPARTMENT OF MINES  
OIL AND GAS DIVISION

1580

WELL RECORD

Permit No. KAN-832-A


Oil or Gas Well \_\_\_\_\_  
(KIND)

Company Krebs Oil Company  
Address Box 213-Charleston, W. Va.  
Farm M. J. Shirkey Acres 90  
Location (waters) Indian Creek  
Well No. 5 Elev. \_\_\_\_\_  
District Elk County Kanawha  
The surface of tract is owned in fee by Dr. W. F. Shirkey  
Shirkey Address Charleston, W. Va.  
Mineral rights are owned by Dr. W. F. Shirkey  
Charleston, Address W. Va.  
Drilling commenced \_\_\_\_\_  
Drilling completed \_\_\_\_\_  
Date Shot \_\_\_\_\_ From \_\_\_\_\_ To \_\_\_\_\_  
With \_\_\_\_\_  
Open Flow /10ths Water in \_\_\_\_\_ Inch  
/10ths Merc. in \_\_\_\_\_ Inch  
Volume \_\_\_\_\_ Cu. Ft.  
Rock Pressure \_\_\_\_\_ lbs. \_\_\_\_\_ hrs.  
Oil \_\_\_\_\_ bbls., 1st 24 hrs.  
Fresh water \_\_\_\_\_ feet \_\_\_\_\_ feet  
Salt water \_\_\_\_\_ feet \_\_\_\_\_ feet

Casing and Tubing	Used in Drilling	Left in Well	Packers
Size			
16			Kind of Packer _____
13			
10			Size of _____
8 1/2	400'	--	
6 5/8	1465'	1465'	Depth set _____
5 3/16			
3			Perf. top _____
2			Perf. bottom _____
Liners Used			Perf. top _____
			Perf. bottom _____

CASING CEMENTED \_\_\_\_\_ SIZE \_\_\_\_\_ No. Ft. \_\_\_\_\_ Date \_\_\_\_\_  
COAL WAS ENCOUNTERED AT \_\_\_\_\_ FEET \_\_\_\_\_ INCHES  
\_\_\_\_\_ FEET \_\_\_\_\_ INCHES FEET \_\_\_\_\_ INCHES  
\_\_\_\_\_ FEET \_\_\_\_\_ INCHES FEET \_\_\_\_\_ INCHES

Formation	Color	Hard or Soft	Top	Bottom	Oil, Gas or Water	Depth Found	Remarks
Sand				100			
Slate			100	140			
Sand			140	200			
Slate			200	250			
Sand			250	290			
Coal			290	300			
Sand			300	360			
Slate			360	390			
Sand			390	490			
Slate and Shells			490	740			
Salt Sand			740	1120			
Maxon Sand			1120	1390			
Slate			1390	1400			
Little Lime			1400	1428			
Slate			1428	1433			
Grey Sand			1433	1450			
Big Lime			1450	1600			
Red Rock and Slate			1600	1719			
Squaw Sand			1719	1729			
TOTAL DEPTH				1732 1/2'			
SUPPLEMENTARY RECORD:							
Weir Sand			1835	1884	Green Oil	1840'-1848'	
TOTAL DEPTH				1884'			

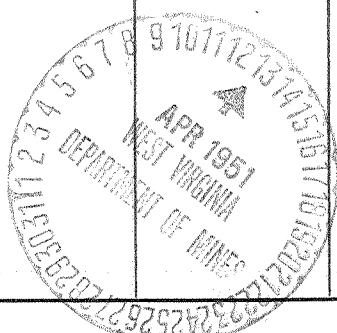

AUG 27 1951