

Company VALLEY STEEL PRODUCTS CO.
 Address ST. LOUIS, MISSOURI
 Farm JESSE JAMES
 Tract _____ Acres 68 1/4 Lease No. _____
 Well (Farm) No. 1 Serial No. F-1620
 Elevation (Spirit Level) 1005'
 Quadrangle CLENDENIN
 County KANAWHA District BIG SANDY
 Engineer PAUL E. JOACHIM
 Engineer's Registration No. 669
 File No. 72-67 Drawing No. _____
 Date APRIL 21, 1951 Scale 1" = 400'

STATE OF WEST VIRGINIA
 DEPARTMENT OF MINES
 OIL AND GAS DIVISION
 CHARLESTON

WELL LOCATION MAP
 FILE NO. KAN-863-A

+ Denotes location of well on United States Topographic Maps, scale 1 to 62,500. latitude and longitude lines being represented by border lines as shown.

- Denotes one inch spaces on border line of original tracing.

6-0-217



STATE OF WEST VIRGINIA
DEPARTMENT OF MINES
OIL AND GAS DIVISION

1603

WELL RECORD

Permit No. KAN-863-A


Oil or Gas Well _____
(KIND)

Company Valley Steel Products Company
 Address Saint Louis, Mo.
 Farm Jesse James Acres 68 1/4
 Location (waters) Will Fork of Jordan Cr.
 Well No. 1 Elev. 1005'
 District Big Sandy County Kanawha
 The surface of tract is owned in fee by _____
 Address _____
 Mineral rights are owned by _____
 Address _____
 Drilling commenced _____
 Drilling completed _____
 Date Shot _____ From _____ To _____
 With _____
 Open Flow _____ /10ths Water in _____ Inch
 _____ /10ths Merc. in _____ Inch
 Volume _____ Cu. Ft.
 Rock Pressure _____ lbs. _____ hrs.
 Oil _____ bbls., 1st 24 hrs.
 Fresh water _____ feet _____ feet
 Salt water _____ feet _____ feet

| Casing and Tubing | Used in Drilling | Left in Well | Packers |
|-------------------|------------------|--------------|----------------|
| Size | | | |
| 16 | | | Kind of Packer |
| 13 | | | |
| 10 | | | Size of |
| 8 1/4 | 618' | 618' | |
| 6 3/8 | 1812' | 1812' | Depth set |
| 5 3/16 | | | |
| 3 | | | Perf. top |
| 2 | | | Perf. bottom |
| Liners Used | | | Perf. top |
| | | | Perf. bottom |

CASING CEMENTED _____ SIZE _____ No. Ft. _____ Date _____
 COAL WAS ENCOUNTERED AT 563 FEET _____ INCHES
 _____ FEET _____ INCHES FEET _____ INCHES
 _____ FEET _____ INCHES FEET _____ INCHES

| Formation | Color | Hard or Soft | Top | Bottom | Oil, Gas or Water | Depth Found | Remarks |
|----------------|-------|--------------|------|--------|-------------------|-------------|---------|
| Coal | | | 563 | 567 | | | |
| Salt Sand | | | 1160 | 1630 | | | |
| Maxon Sand | | | 1695 | 1725 | | | |
| Big Lime | | | 1782 | 1920 | | | |
| Big Injun Sand | | | 1920 | 1960 | | | |
| Squaw Sand | | | 2066 | 2082 | | | |
| TOTAL DEPTH | | | | 2086 | | | |

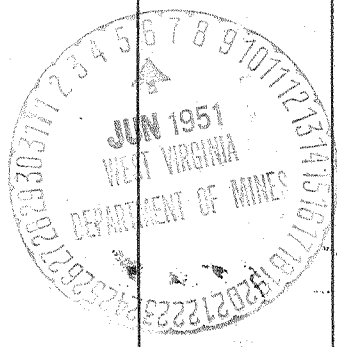

NOV 28 1951