

Company VALLEY STEEL PRODUCTS Co.
 Address ST. LOUIS, MISSOURI
 Farm MARY S. DODD
 Tract _____ Acres 59^{3/8} Lease No. _____
 Well (Farm) No. 1 Serial No. F-1505
 Elevation (Spirit Level) 942
 Quadrangle WALTON
 County KANAWHA District ELK
 Engineer PAUL E. JOACHIM
 Engineer's Registration No. 669
 File No. 70-71 Drawing No. _____
 Date APRIL 28, 1951 Scale 1" = 400'

STATE OF WEST VIRGINIA
 DEPARTMENT OF MINES
 OIL AND GAS DIVISION
 CHARLESTON

WELL LOCATION MAP
 FILE NO. KAN-865-A

+ Denotes location of well on United States Topographic Maps, scale 1 to 62,500; latitude and longitude lines being represented by border lines as shown.

- Denotes one inch spaces on border line of original tracing.

MARY S. DODD No. 1 (F-1505) - VALLEY STEEL PRODUCTS Co. - KAN-865-A

MARY S. DODD NO. 1 WELL.

2004

Blk District, Kanawha County, W. Va.
By Valley Steel Products Co., St. Louis, Mo.
Abandoned under permit Kan-.....-A?
On 59-3/8 acres.
Elevation, 942' L.
Date of completion, etc., not given.
8 1/4" casing, 710'; 6 3/8", 1835'; all left in.
Gas well. Record to Dept. of Mines stamped June 6, 1951.
Record to RCT from Mrs. Griffith Nov. 28, 1951. Old File No. 1590.

	Top.	Bottom.
Salt Sands	1360	- 1667
Maxton Sand	1720	- 1740
Little Line	1748	- 1754
Big Line	1762	- 1885
Big Injun Sand	1885	- 1915
Total depth		1930



1590

STATE OF WEST VIRGINIA
DEPARTMENT OF MINES
OIL AND GAS DIVISION

WELL RECORD

Permit No. KAN-865-A


Oil or Gas Well _____
(KIND)

Company Valley Steel Products Company
 Address Saint Louis, Mo.
 Farm Mary S. Dodd Acres 59-3/8
 Location (waters) _____
 Well No. 1 Elev. 942
 District Elk County Kanawha
 The surface of tract is owned in fee by _____
 Address _____
 Mineral rights are owned by _____
 Address _____
 Drilling commenced _____
 Drilling completed _____
 Date Shot _____ From _____ To _____
 With _____
 Open Flow _____ /10ths Water in _____ Inch
 _____ /10ths Merc. in _____ Inch
 Volume _____ Cu. Ft.
 Rock Pressure _____ lbs. _____ hrs.
 Oil _____ bbls., 1st 24 hrs.
 Fresh water _____ feet _____ feet
 Salt water _____ feet _____ feet

Casing and Tubing	Used in Drilling	Left in Well	Packers
Size			
16			Kind of Packer
13			
10			Size of
8 1/4	710'	710'	
6 5/8	1835'	1835'	Depth set
5 3/16			
3			Perf. top
2			Perf. bottom
Liners Used			Perf. top
			Perf. bottom

CASING CEMENTED _____ SIZE _____ No. Ft. _____ Date _____
 COAL WAS ENCOUNTERED AT _____ FEET _____ INCHES
 _____ FEET _____ INCHES FEET _____ INCHES
 _____ FEET _____ INCHES FEET _____ INCHES

Formation	Color	Hard or Soft	Top	Bottom	Oil, Gas or Water	Depth Found	Remarks
Salt Sands			1360'	1667'			
Maxon Sand			1720	1740			
Little Lime			1748	1754			
Big Lime			1762	1885			
Big Injun Sand			1885	1915			
TOTAL DEPTH				1930			

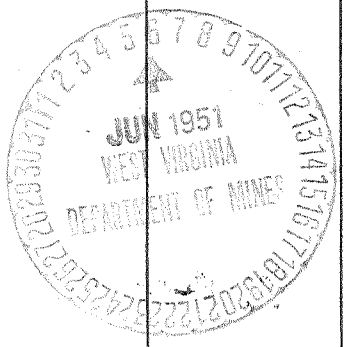

NOV 28 1951