

Company THE PRESTON OIL CO.  
 Address CHARLESTON, WVA  
 Farm J.D. KITTINGER  
 Tract \_\_\_\_\_ Acres 39 Lease No. 27189  
 Well (Farm) No. 1, 2, 3 Serial No. 3254  
3289  
3290  
 Elevation (Spirit Level) AS SHOWN  
 Quadrangle MONTGOMERY  
 County KANAWHA District CABIN CREEK  
 Engineer \_\_\_\_\_  
 Engineer's Registration No. 662  
 File No. 70-43 Drawing No. \_\_\_\_\_  
 Date JULY 28, 1951 Scale 1" = 200'

STATE OF WEST VIRGINIA  
 DEPARTMENT OF MINES  
 OIL AND GAS DIVISION  
 CHARLESTON

WELL LOCATION MAP  
 FILE NO. KAN-867-A-#3289  
KAN-868-A-#3290  
KAN-878-A-#3254

+ Denotes location of well on United States Topographic Maps, scale 1 to 62,500, latitude and longitude lines being represented by border lines as shown.  
 - Denotes one inch spaces on border line of original tracing.

Cabin Creek District, Kanawha County, W. Va.

By The Preston Oil Co., 1110 E. Washington St., Charleston, W. Va.

Abandoned under permit Kan-.....-A?

On 39 acres, on Cabin Creek.

Elevation, ..... ' L.

Drilling commenced Sept. 16, 1916; completed Dec. 2, 1916.

Shot Dec. 2, 1916, at 2400-2416', with 80 qts.

Oil, 125 bbls., 1st 24 hrs.

13" casing, 33'; 10", 440'; 8 $\frac{1}{2}$ ", 1080' (pulled); 6 $\frac{5}{8}$ ", 1763'; 5 $\frac{7}{16}$ ", 1837'.

Oil well. Record to Dept. of Mines stamped June 18, 1951.

Record to ROT from Mrs. Griffith Aug. 17, 1951. Old File No. 1568.

	Top.	Bottom.
Clay and sand	0	30
Sand (water, 33')	30	44
Slate	44	74
Sand (water, 125')	74	133
Slate	133	198
Slate and shells	198	233
Lime and shells	233	295
Sand	295	370
Coal	370	373
Slate	373	387
Sand	387	410
Slate	410	440
Sand	440	455
Slate	455	480
Sand	480	585
Grampus Sand	585	790
Slate	790	795
Salt Sand	795	1075
Slate	1075	1080
Sand and lime	1080	1220
Red rock	1220	1260
Lime and shells	1260	1270
Slate and shells	1270	1565
Maxton Sand (water, 1595')	1565	1635
Slate and shells	1635	1670
Little Lime	1670	1690
Pencil Cave	1690	1700
Big Lime	1700	1955
Big Injun Sand	1955	1990
Slate and shells	1990	2371
Brown shale	2371	2381
Berea Grit (gas, 2401'; oil, 2405')	2381	2417
Total depth		2420



STATE OF WEST VIRGINIA  
DEPARTMENT OF MINES  
OIL AND GAS DIVISION

1588

Permit No. KAN-867-A  
Was 70057

WELL RECORD


Oil or Gas Well \_\_\_\_\_  
(KIND)

Company The Preston Oil Company  
 Address 1110 E. Washington St. Charleston, W. Va.  
 Farm J. D. Kittinger Acres 39  
 Location (waters) Cabin Creek  
 Well No. 3289 Elev. \_\_\_\_\_  
 District Cabin Creek County Kanawha  
 The surface of tract is owned in fee by \_\_\_\_\_  
 Address \_\_\_\_\_  
 Mineral rights are owned by \_\_\_\_\_  
 Address \_\_\_\_\_  
 Drilling commenced September 16, 1916  
 Drilling completed December 2, 1916  
 Date Shot 12-2-16 From 2400 To 2416  
 With 80 quarts  
 Open Flow /10ths Water in \_\_\_\_\_ Inch  
 /10ths Merc. in \_\_\_\_\_ Inch  
 Volume \_\_\_\_\_ Cu. Ft.  
 Rock Pressure \_\_\_\_\_ lbs. \_\_\_\_\_ hrs.  
 Oil 125 bbls., 1st 24 hrs.  
 Fresh water \_\_\_\_\_ feet \_\_\_\_\_ feet  
 Salt water \_\_\_\_\_ feet \_\_\_\_\_ feet

Casing and Tubing	Used in Drilling	Left in Well	Packers
Size			Kind of Packer
16			
13	33	33	
10	440	440	Size of
8 1/2	1080	-	
6 5/8	1763	1763	Depth set
5 3/16	1837	1837	
3			Perf. top
2			Perf. bottom
Liners Used			Perf. top
			Perf. bottom

CASING CEMENTED \_\_\_\_\_ SIZE \_\_\_\_\_ No. Ft. \_\_\_\_\_ Date \_\_\_\_\_  
 COAL WAS ENCOUNTERED AT \_\_\_\_\_ FEET \_\_\_\_\_ INCHES  
 \_\_\_\_\_ FEET \_\_\_\_\_ INCHES FEET \_\_\_\_\_ INCHES  
 \_\_\_\_\_ FEET \_\_\_\_\_ INCHES FEET \_\_\_\_\_ INCHES

Formation	Color	Hard or Soft	Top	Bottom	Oil, Gas or Water	Depth Found	Remarks
Clay & Sand			0	30	Water XXX	33'	
Sand			30	44			
Slate			44	74			
Sand			74	133	Water	125'	
Slate			133	198			
Slate & Shells			198	233			
Lime & Shells			233	295			
Sand			295	370			
Coal			370	373			
Slate			373	387			
Sand			387	410			
Slatg			410	440			
Sand			440	455			
Slate			455	480			
Sand			480	585			
Gramphis			585	790			
Slate			790	795			
Salt Sand			795	1075			
Slate			1075	1080			
Sand & Lime			1080	1220			
Red Rock			1220	1260			
Lime & Shells			1260	1270			
Slate & Shells			1270	1565			
Maxon			1565	1635	Water	1595'	
Slate & Shells			1635	1670			
Little Lime			1670	1690			
Pencil Cave			1690	1700			
Big Lime			1700	1955			
Big Injun			1955	1990			
Slate & Shells			1990	2371			
Brown Shale			2371	2381			
Berea Grit			2381	2417	Gas	2401'	
TOTAL DEPTH				2420	Oil	2405'	

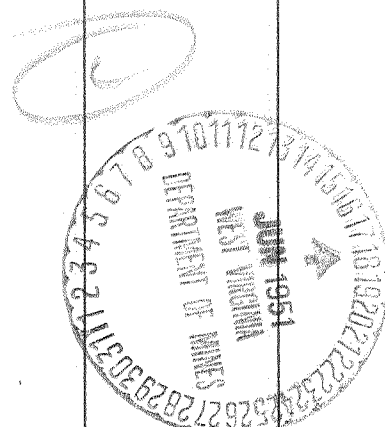

Cabin Creek District, Kanawha County, W. Va.  
 By The Ohio Fuel Oil Co. (Virginian Gasoline & Oil Co.)  
 On ~~W. D. Williams~~ lease No. 1986; 39 acres.  
 Drilling contractor, Jack McCall and H. P. Donold, Huntington, W. Va.  
 Commenced Sept. 16, 1916; completed Dec. 2, 1916.  
 12 $\frac{1}{2}$ " casing, 33'; 10", 440'; 8 $\frac{1}{4}$ ", 1080' (pulled); 6 $\frac{1}{2}$ ", 1763'.  
 Shot Dec. 2, 1916, with 80 qts.  
 Oil, pumped 125 bbls., 1st 24 hrs.

	Top.	Bottom.	Thickness.
Sand (33' of 12 $\frac{1}{2}$ " casing)	30	44	14
Slate	44	74	30
Sand	74	133	59
Slate	133	198	65
Slate and shells	198	233	35
Lime shells	233	295	62
Sand	295	370	75
Coal	370	373	3
Slate	373	387	14
Sand	387	410	23
Slate	410	440	30
Sand	440	455	15
Slate	455	480	25
Sand	480	585	105
Gramphis Sand	585	790	205
Slate	790	795	5
Salt Sand (hole full water at 125' in)	795	1075	280
Slate	1075	1080	5
Sand and lime	1080	1220	140
Red rock	1220	1260	40
Lime shells	1260	1270	10
Slate and shells	1270	1565	295
Maxton Sand (water at 1585')	1565	1635	70
Slate and shells	1635	1670	35
Little Lime	1670	1690	20
Pencil Cave	1690	1700	10
Big Lime	1700	1955	255
Big Injun Sand	1955	1990	35
Slate and shells	1990	2371	381
Brown shale	2371	2381	10
Berea Grit (gas at 2401'; oil at 2405')	2381	2417	36
Pocket	2417	2420	3
Total depth		2420	



STATE OF WEST VIRGINIA  
DEPARTMENT OF MINES  
OIL AND GAS DIVISION

1668

WELL RECORD

Permit No. KAN-867-A was 70057

Abandonment

Oil or Gas Well Oil  
(KIND)


Company The Preston Oil Company  
Address P. O. Box 1273, Charleston 25, W.Va.  
Farm J. D. Kittinger Acres 39  
Location (waters) Cabin Creek  
Well No. 3289 Elev. 702 L  
District Cabin Creek County Kanawha  
The surface of tract is owned in fee by \_\_\_\_\_  
Address \_\_\_\_\_  
Mineral rights are owned by Stanley E. Parks, et al  
P. O. Box 211 Address Stubenville, Ohio  
Drilling commenced 9-16-16  
Drilling completed 12-2-16  
Date Shot 12-2-16 From Not given To \_\_\_\_\_  
With 80 qts.  
Open Flow /10ths Water in \_\_\_\_\_ Inch  
/10ths Merc. in \_\_\_\_\_ Inch  
Volume \_\_\_\_\_ Cu. Ft.  
Rock Pressure \_\_\_\_\_ lbs. \_\_\_\_\_ hrs.  
Oil 125 bbls., 1st 24 hrs.  
Fresh water 33,125 feet \_\_\_\_\_ feet  
Salt water 1585' feet \_\_\_\_\_ feet

Casing and Tubing	Used in Drilling	Left in Well	Packers
Size			
16			Kind of Packer _____
<del>18</del> <u>12 1/2</u>	<u>33'</u>	<u>33'</u>	
10	<u>440'</u>	<u>440'</u>	Size of _____
8 1/4	<u>1080'</u>	<u>Pulled</u>	
<del>6 3/8</del> <u>6 1/2</u>	<u>1763'</u>	<u>1763'</u>	Depth set _____
5 3/16	<u>1837'</u>	<u>1837'</u>	
3			Perf. top _____
2		<u>2417'</u>	Perf. bottom _____
Liners Used _____			Perf. top _____
			Perf. bottom _____

CASING CEMENTED \_\_\_\_\_ SIZE \_\_\_\_\_ No. Ft. \_\_\_\_\_ Date \_\_\_\_\_

COAL WAS ENCOUNTERED AT 370 FEET 36 INCHES  
\_\_\_\_\_  
FEET INCHES FEET INCHES  
\_\_\_\_\_  
FEET INCHES FEET INCHES

Formation	Color	Hard or Soft	Top	Bottom	Oil, Gas or Water	Depth Found	Remarks
Surface Clay			0	30			
Sand			30	44		33'	Hole filled up
Slate			44	74			
Sand			74	133	Water	125'	Hole Full
Slate			133	198			
Slate & Shales			198	233			
Lime & Shells			233	295			
Sand			295	370			
Coal			370	373			
Slate			373	387			
Sand			387	410			
Slate			410	440			
Sand			440	455			
Slate			455	480			
Sand			480	585			
Granphis			585	790			
Slate			790	795			
Salt Sand			795	1075			
Slate			1075	1080			
Sand & Lime			1080	1220			
Red Rock			1220	1260			
Lime Shells			1260	1270			
Slate & Shells			1270	1565			
Maxon			1565	1635	Water	1585'	
Slate & Shells			1635	1670			
Little Lime			1670	1690			
Pencil Cave			1690	1700			
Big Lime			1700	1955			
Big Injun			1955	1990			
Slate & Shells			1990	2371			
Brown Shale			2371	2381	Gas	2401'	
Berea Grit			2381	2417	Oil	2405'	
Pocket			2417	2420			
Total depth				2420			

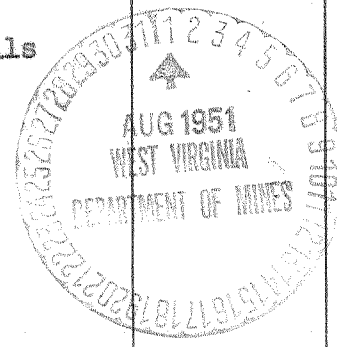

(Over)

JUL 9 1952

