

Company	PACK & JACKSON
Address	HAMLIN, W. VA.
Farm	JACKSON MYERS
Tract	Acres 39 Lease No.
Well (Farm) No.	3 Serial No. F-2810
Elevation (Spirit Level)	995.6
Quadrangle	CLENDENIN
County	KANAWHA District ELK
Engineer	PAUL E. JOACHIM
Engineer's Registration No.	669
File No.	70-63 Drawing No.
Date	JUNE 24, 1951 Scale 1" = 400'

STATE OF WEST VIRGINIA
 DEPARTMENT OF MINES
 OIL AND GAS DIVISION
 CHARLESTON

WELL LOCATION MAP
 FILE NO. KAN - 876-A

+ Denotes location of well on United States Topographic Maps, scale 1 to 62,500, latitude and longitude lines being represented by border lines as shown.

- Denotes one inch spaces on border line of original tracing.

6-0-217

JACKSON MYERS NO. 3 (F-2810) - PACK & JACKSON - KAN-876-A

JACKSON MYERS NO. 3 WELL.

Blk District, Kanawha County, W. Va.

By Peck & Jackson, (Hal Peck, Hamlin, W. Va.

Abandoned under permit Kan-.....-A?

On 39 acres.

Elevation, 995.6' L.

Drilling completed in 1917.

Shot record: Shot Sept. 24, 1917, with 120 qts., at 1982'.

8 $\frac{1}{2}$ " casing, 418'; 7" O. D., 1683'; 5 $\frac{1}{2}$ " , 609' (reserved); 2" tubing, 2070' (reserved).

Formerly South Penn Oil Co. well.

Oil well. Record to Dept. of Mines stamped July 9, 1951.

Record to RCT from Mrs. Griffith Jan. 16, 1952. Old File No. 1627.

	Top.	Bottom.
Coal	347	- 350
Salt Sand	960	- 1454
Maxton Sand	1555	- 1585
Big Lime	1650	- 1815
Big Injun Sand (gas, 1820')	1815	- 1830
Weir Sand (gas, 1970'; oil, 1985-2010'; oil, 2050-2060')	1965	- 2065
Total depth		2070



STATE OF WEST VIRGINIA
DEPARTMENT OF MINES
OIL AND GAS DIVISION

1627

WELL RECORD

Formerly: South Fern Oil Co.

Permit No. KAN-876-A

Oil or Gas Well (KIND)

Company Peck & Jackson
 Address c/o Hal Peck - Hamlin, W. Va.
 Farm Jackson Myers Acres 39
 Location (waters) _____
 Well No. 3 Elev. 905.6'
 District Elk County Kanawha
 The surface of tract is owned in fee by _____
 Address _____
 Mineral rights are owned by _____
 Address _____
 Drilling commenced _____
 Drilling completed 1917
 Date Shot _____ From _____ To _____
 With _____
 Open Flow /10ths Water in _____ Inch
 /10ths Merc. in _____ Inch
 Volume _____ Cu. Ft.
 Rock Pressure _____ lbs. _____ hrs.
 Oil _____ bbls., 1st 24 hrs.
 Fresh water _____ feet _____ feet
 Salt water _____ feet _____ feet

Casing and Tubing	Used in Drilling	Left in Well	Packers
Size			Kind of Packer
16			
13			
10			Size of
8 1/2 8-5/8"	418	418	
6 5/8 7" OD	1685	1685	Depth set
5 3/16 5 1/2	600	reserved	
3			Perf. top
2	2070	reserved	Perf. bottom
Liners Used			Perf. top
			Perf. bottom


CASING CEMENTED _____ SIZE _____ No. Ft. _____ Date _____

COAL WAS ENCOUNTERED AT _____ FEET _____ INCHES
 _____ FEET _____ INCHES FEET _____ INCHES
 _____ FEET _____ INCHES FEET _____ INCHES

Formation	Color	Hard or Soft	Top	Bottom	Oil, Gas or Water	Depth Found	Remarks
Coal			347	350			
Salt Sand			960	1454			
Maxon Sand			1555	1585			
Big Lime			1650	1815			
Big Injun			1816	1830			
Gas			1820				
Weir Sand			1965	2065			
Gas			1970				
Oil			1985	2010			
Oil			2050	2060			
Total Depth				2070			

SHOT RECORD

9/24/17 120 qts. 1981

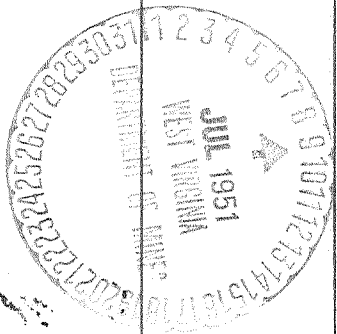

JAN 16 1952