

New Location
 Drill Deeper
 Abandonment

Company THE PRESTON OIL CO.
 Address CHARLESTON, WVA
 Farm J.D. KITTINGER
 Tract _____ Acres 39 Lease No. 27189
 Well (Farm) No. 1, 2 & 3 Serial No. 3254
 Elevation (Spirit Level) AS SHOWN
 Quadrangle MONTGOMERY
 County KANAWHA District CABIN CREEK
 Engineer _____
 Engineer's Registration No. 662
 File No. 70-43 Drawing No. _____
 Date JULY 28, 1951 Scale 1" = 200'

STATE OF WEST VIRGINIA
 DEPARTMENT OF MINES
 OIL AND GAS DIVISION
 CHARLESTON

WELL LOCATION MAP
 FILE NO. KAN-867-A-#3299-
KAN-868-A-#3290-
KAN-875-A-#3254-

+ Denotes location of well on United States Topographic Maps, scale 1 to 62,500, latitude and longitude lines being represented by border lines as shown.
 - Denotes one inch spaces on border line of original tracing.

J.D. KITTINGER MS. 2, 3 & 1 - PRESTON OIL CO. - KAN-867-8-A, 878-A

J. D. KITTINGER NO. 1 (736) WELL.

70056
O.F.-Kan-1007.

Nov 878A

Cabin Creek District, Kanawha County, W. Va.
By The Ohio Fuel Oil Co. (Virginian Gasoline & Oil Co.).
Drilling contractor, F. S. Bigley & Co., Huntington, W. Va.
Cost per foot, \$1.65.
Commenced May 4, 1916; completed July 18, 1916? (1916?).
13" casing, 16'; 10", 410'; 8½", 1070' (pulled); 6¾", 1726' 6".
Shot July 25, 1916, with 120 qts.
Oil, pumped 110 bbls., 1st 24 hrs.

	Top.	Bottom.	Thickness.
Gravel	0	- 16	16
Sand (water, 31')	16	- 34	18
Coal	34	- 36	2
Sand	36	- 220	184
Slate	220	- 250	30
Sand	250	- 300	50
Slate	300	- 350	50
Sand	350	- 400	50
Slate	400	- 425	25
Black lime	425	- 505	80
Slate	505	- 540	35
Hard sand	540	- 695	155
Slate	695	- 730	35
Salt Sand	730	- 1040	310
Slate	1040	- 1045	5
Sand	1045	- 1093	48
Slate and shells	1093	- 1170	77
Slate	1170	- 1200	30
Red rock (cemented cave, 1200-1240')	1200	- 1240	40
Sand	1240	- 1280	40
Slate (cemented cave, 1275-1500')	1280	- 1500	220
Maxton Sand (salt water, 2 bailers per hour)	1400	- 1600	100
Black lime	1600	- 1650	50
Slate	1650	- 1670	20
Little Lime	1670	- 1695	25
Pencil Cave	1695	- 1697	2
Big Lime	1697	- 1908	211
Big In Sand, red	1908	- 1943	35
Slate and shells	1943	- 2320	386
Brown shale	2329	- 2349	20
Berea Sand	2349	- 2399	50
Total depth		2403	

J. D. KITTINGER NO. 3254 WELL.

Cabin Creek District, Kanawha County, W. Va.

By The Preston Oil Co., 1110 Washington St., East, Charleston, W. Va.

Abandoned under permit No.-37

On 39 acres.

Elevation,' L.

Drilling commenced May 4, 1916; completed July 18, 1916.

Shot July 25, 1916, with 120 qts.

Oil, 110 hbbl., 1st 24 hrs.

13" casing, 16'; 10", 410'; 8", 1070' (pulled); 6", 1726' 6".

Oil well. Record to Dept. of Mines stamped July 9, 1951.

Record to RCW from Mrs. Griffith Aug. 27, 1951. Old File No. 1583.

	Top.	Bottom.
Gravel	0	16
Sand	16	34
Coal	34	36
Sand	36	220
Slate	220	250
Sand	250	300
Slate	300	350
Sand	350	400
Slate	400	425
Black lime	425	505
Slate	505	540
Hard sand	540	695
Slate	695	730
Salt Sand	730	1040
Slate	1040	1045
Sand	1045	1093
Slate and shells	1093	1170
Slate	1170	1200
Red rock (cemented core, 1200-1240')	1200	1240
Sand	1240	1280
Slate (cemented core, 1475-1500')	1280	1500
Marion Sand (salt water, 2 blrs./hr.)	1500	1600
Black lime	1600	1650
Slate	1650	1670
Little lime	1670	1695
Pencil Gave	1695	1697
Big Lime	1697	1908
Big Injun Sand, red	1908	1943
Slate and shells	1943	2329
Brown shale	2329	2349
Berea Sand	2349	2399
Total depth		2403



1583

STATE OF WEST VIRGINIA
DEPARTMENT OF MINES
OIL AND GAS DIVISION

WELL RECORD

Permit No. KAN-878-A

Oil or Gas Well Oil (KIND)

Was 70056


Company The Preston Oil
 Address 1110 Washington Street, East
 Farm J. D. Kittinger Acres 39
 Location (waters) Cabin Creek Kanawha Co. W. Va.
 Well No. 3254 Elev. _____
 District Cabin Creek County Kanawha
 The surface of tract is owned in fee by _____
 Address _____
 Mineral rights are owned by _____
 Address _____
 Drilling commenced May 4, 1916
 Drilling completed July 16, 1916
 Date Shot 7-25-16 From _____ To _____
 With 120 Gals
 Open Flow /10ths Water in _____ Inch
 /10ths Merc. in _____ Inch
 Volume _____ Cu. Ft.
 Rock Pressure _____ lbs. _____ hrs.
 Oil 110 bbls., 1st 24 hrs.
 Fresh water _____ feet _____ feet
 Salt water _____ feet _____ feet

Casing and Tubing	Used in Drilling	Left in Well	Packers
Size			
16			Kind of Packer
18	16'	16'	
10	410'	410'	Size of
8 1/2	1070'	None	
6 5/8	1726' 6"	1726' 6"	Depth set
5 3/16			
3			Perf. top
2			Perf. bottom
Liners Used			Perf. top
			Perf. bottom

CASING CEMENTED _____ SIZE _____ No. Ft. _____ Date _____

COAL WAS ENCOUNTERED AT _____ FEET _____ INCHES
 _____ FEET _____ INCHES FEET _____ INCHES
 _____ FEET _____ INCHES FEET _____ INCHES

Formation	Color	Hard or Soft	Top	Bottom	Oil, Gas or Water	Depth Found	Remarks
Gravel			0	16			
Sand			16	24			
Coal			24	36			
Sand			36	220			
Slate			220	250			
Sand			250	300			
Slate			300	350			
Sand			350	400			
Slate			400	425			
Black Lime			425	505			
Slate			505	540			
Hard Sand			540	695			
Slate			695	730			
Salt Sand			730	1040			
Slate			1040	1045			
Sand			1045	1093			
Slate & Shells			1093	1170			
Slate			1170	1200			
Red Rock			1200	1240			1200 to 1240 Cemented Caves
Sand			1240	1280			
Slate			1280	1300			1475 to 1500 " "
Maxon Sand			1500	1600			Salt Water 2 builers per hr.
Black Lime			1600	1650			
Slate			1650	1670			
Little Lime			1670	1695			
Pencil Cave			1695	1697			
Big Lime			1697	1908			
Red Big Injun			1908	1943			
Slate & Shells			1943	2329			
Brown Shale			2329	2349			
Berea Sand			2349	2399			
Bottom Hole				2403			

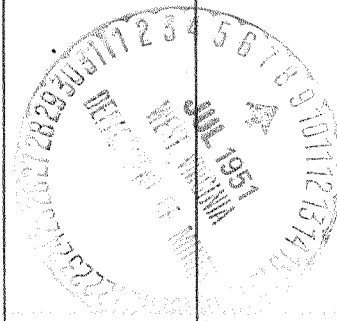

(Over)

AUG 27 1951