

Company SEATEX OIL CO., INC.

Address FALLING ROCK, W. VA.

Farm FALLING ROCK PRODUCING CO.

Tract _____ Acres 3060 Lease No. 1

Well (Farm) No. 19 Serial No. 1054

Elevation (Spirit Level) 632.3

Quadrangle CLENDENIN

County KANAWHA District BIG SANDY

Engineer P. H. Kuebs

Engineer's Registration No. 773

File No. _____ Drawing No. _____

Date 7-6-51 Scale 1" = 1320'

STATE OF WEST VIRGINIA
DEPARTMENT OF MINES
OIL AND GAS DIVISION
CHARLESTON

WELL LOCATION MAP
FILE NO. KAN-879-A

+ Denotes location of well on United States Topographic Maps, scale 1 to 62,500, latitude and longitude lines being represented by border lines as shown.

- Denotes one inch spaces on border line of original tracing.

5-0 220

FALLING ROCK PRODUCING CO., NO. 19 (1054) - SEATEX OIL CO., INC. - KAN-879-A

FALLING ROCK PRODUCING CO. NO. 19 WELL.

8722

Big Sandy District, Kanawha County, W. Va.
 By Valley Steel Products Co., St. Louis, Mo.
 Abandoned under permit Kan-.....-A?
 On 3060 acres, on Elk River.
 Elevation, 632.3' L.
 Date of completion not given.
 Drilled deeper in May 1945. Deepening record not given.
 16" conductor, 16'; 8 1/2" casing, 400'; 3" tubing, 1467'; all left in.
 Gas at 750'. Gas at 1441-1467'. Gas, 1588-1598'.
 Water at 760'.
 Oil at 1695'.
 Packer set at 1525'; perforated 12' from bottom.
 Oil well. Record to Dept. of Mines stamped July 12, 1951.
 Record to RCT from Mrs. Griffith Nov. 28, 1951. Old File No. 1591.

	Top.	Bottom.	
Various formations	0	- 745	
Sand	745	- 975	
Lime and sand	975	- 1126	
Maxton Sand (break, 1126-1250')	1126	- 1250	?
Broken lime	1250	- 1260	
Little Lime	1260	- 1300	
Broken lime	1300	- 1320	
Pencil Cave	1320	- 1324	
Big Lime	1324	- 1440	
Big Injun Sand	1440	- 1467	
Slate and lime shells	1467	- 1537	
Sand, broken	1537	- 1598	
Sand (white sand, 1613-1660')	1660?	- 1700	
Total depth		1725	



STATE OF WEST VIRGINIA
DEPARTMENT OF MINES
OIL AND GAS DIVISION

1591

WELL RECORD

Permit No. KAN-879-A


Oil or Gas Well X
(KIND)

Company Valley Steel Products Company
Address St. Louis, Mo.
Farm Falling Rock Producing Co Acres 3000
Location (waters) Big River
Well No. 10 Elev. 632.5'
District Big Sandy County Kanawha
The surface of tract is owned in fee by _____
Address _____
Mineral rights are owned by _____
Address _____
Drilling commenced _____
Drilling completed drilled deeper in May 1945
Date Shot _____ From _____ To _____
With _____
Open Flow _____ /10ths Water in _____ Inch
_____ /10ths Merc. in _____ Inch
Volume _____ Cu. Ft.
Rock Pressure _____ lbs. _____ hrs.
Oil _____ bbls., 1st 24 hrs.
Fresh water _____ feet _____ feet
Salt water _____ feet _____ feet

Casing and Tubing	Used in Drilling	Left in Well	Packers
Size			
16 Conductor		10'	Kind of Packer
13			
10			Size of
8 1/2	4001	4001	Depth set
6 1/2			
5 3/16			
3	1467	1467	Perf. top
2			Perf. bottom
Liners Used			Perf. top
			Perf. bottom

CASING CEMENTED _____ SIZE _____ No. Ft. _____ Date _____
COAL WAS ENCOUNTERED AT _____ FEET _____ INCHES
_____ FEET _____ INCHES FEET _____ INCHES
_____ FEET _____ INCHES FEET _____ INCHES

Formation	Color	Hard or Soft	Top	Bottom	Oil, Gas or Water	Depth Found	Remarks
Various Formations			0	745	Gas at 730'		
Sand			745	875	Water at 760'		
Lime and Sand			875	1126			
Broken Sand			1126	1250	Break 1126-1250		
Broken Lime			1250	1300			
Little Lime			1300	1500			
Broken Lime			1300	1380			
Pencil Cave			1380	1384			
Big Lime			1384	1440	Gas 1441 to 1467'		
Big Injun			1440	1467			
Slate and Lime shells			1467	1537			
Sand - broken			1537	1590	Gas 1530' - 1590'		
Sand			1590	1700	White Sand 1613-1660'		
Total Depth			1725	1725	Oil at 1695'		
					Packer set at 1695' - perforated 12' from bottom		

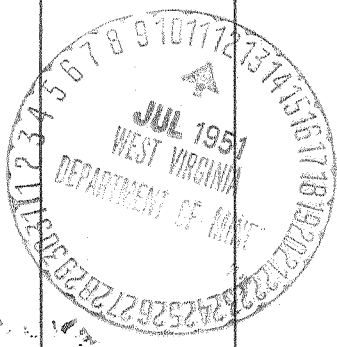

NOV 28 1951