

Company SEATEX OIL CO., INC.
 Address FALLING ROCK, W.VA.
 Farm FALLING ROCK PRODUCING CO.
 Tract _____ Acres 3060 Lease No. 1
 Well (Farm) No. 66-67-89 Serial No. AS ABOVE
 Elevation (Spirit Level) AS ABOVE
 Quadrangle CLENDENIN
 County KANAWHA District BIG SANDY
 Engineer C. G. KREBS
 Engineer's Registration No. 773
 File No. _____ Drawing No. _____
 Date 7-6-51 Scale 1" = 1320'

STATE OF WEST VIRGINIA
 DEPARTMENT OF MINES
 OIL AND GAS DIVISION
 CHARLESTON

WELL LOCATION MAP

FILE NO. _____

+ Denotes location of well on United States Topographic Maps, scale 1 to 62,500, latitude and longitude lines being represented by border lines as shown.

- Denotes one inch spaces on border line of original tracing.

FALLING ROCK PRODUCING Co, No. 28, 54, 66, 67 & 89 - SEATEX OIL CO., INC. - KAN-880-1-23
 KAN-885-A

FALLING ROCK PRODUCING CO. NO. 89 WELL.

885A

Big Sandy District, Kanawha County, W. Va.
 By Valley Steel Products Co., St. Louis, Mo.
 Abandoned under permit Kan-.....-A?
 On 3060 acres, on Falling Rock Creek.
 Elevation, 840' L.

Date of completion, etc., not given.
 16" conductor, 9"; 8 1/2" casing, 350'; 2" tubing, 1804'; all left in.
 ("?) casing set at 1391'.

Gas well. Record to Dept. of Mines stamped July 12, 1951.
 Record to RGT from Mrs. Griffith Nov. 28, 1951. Old File No. 1600.

	Top.	Bottom.
Sand	9	50
Slate	50	100
Sand	100	150
Slate	150	200
Sand	200	275
Slate	275	300
Sand	300	360
Slate	360	430
Sand	430	660
Slate	660	670
Salt Sand	670	1010
Slate	1010	1015
Sand	1015	1160
Lime	1160	1205
Red rock	1205	1220
Lime and sand	1220	1230
Red rock	1230	1255
Slate and lime	1255	1285
Morton Sand	1285	1318
Black cave	1318	1325?
Little Lime	1323?	1353
Slate	1353	1355
Hard sand	1355	1359
Pencil Cave	1359	1364 1/2
Big lime	1364 1/2	1543
Big Injun Sand	1543	1548
Slate	1548	1588
Weir Sand (first show of oil, 1691 1/2'; second show of gas, 1774')	1588	1789
Slate	1789	1804
Total depth		1804



STATE OF WEST VIRGINIA
DEPARTMENT OF MINES
OIL AND GAS DIVISION

1600

WELL RECORD

Permit No. KAN-885-A


Oil or Gas Well X (KIND)

Company Valley Steel Products Company
 Address St. Louis, Mo.
 Farm Falling Rock Producing Co. Acres 3000
 Location (waters) Falling Rock Creek
 Well No. 88 Elev. 840.1
 District Big Sandy County Lincoln
 The surface of tract is owned in fee by _____
 Address _____
 Mineral rights are owned by _____
 Address _____
 Drilling commenced _____
 Drilling completed _____
 Date Shot _____ From _____ To _____
 With _____
 Open Flow _____ /10ths Water in _____ Inch
 _____ /10ths Merc. in _____ Inch
 Volume _____ Cu. Ft.
 Rock Pressure _____ lbs. _____ hrs.
 Oil _____ bbls., 1st 24 hrs.
 Fresh water _____ feet _____ feet
 Salt water _____ feet _____ feet

Casing and Tubing	Used in Drilling	Left in Well	Packers
Size			
16 Conductor		91'	Kind of Packer
13			
10			Size of
8 1/2	300'	300'	
6 5/8			Depth set
5 3/16			
3			Perf. top
2	1804'	1804'	Perf. bottom
Liners Used			Perf. top
			Perf. bottom

CASING CEMENTED _____ SIZE _____ No. Ft. _____ Date _____
 COAL WAS ENCOUNTERED AT _____ FEET _____ INCHES
 _____ FEET _____ INCHES FEET _____ INCHES
 _____ FEET _____ INCHES FEET _____ INCHES

Formation	Color	Hard or Soft	Top	Bottom	Oil, Gas or Water	Depth Found	Remarks
Sand			0	50			
Slate			50	100			
Sand			100	150			
Slate			150	200			
Sand			200	275			
Slate			275	300			
Sand			300	350			
Slate			350	450			
Sand			450	600			
Slate			600	670			
Salt Sand			670	1010			
Slate			1010	1015			
Sand			1015	1100			
Lime			1100	1205			
Red Rock			1205	1230			
Lime and Sand			1230	1250			
Red Rock			1250	1255			
Slate and Lime			1255	1285			
Maxon Sand			1285	1313			
Black Cave			1313	1325			
Little Lime			1325	1355			
Slate			1355	1355			
Hard Sand			1355	1359			
Pencil Cave			1359	1364 1/2			
Big Lime			1364 1/2	1343			Casing set at 1301'
Injun Sand			1343	1348			
Slate			1348	1388			
Voir Sand			1388	1700			first show of gas 1301 1/2'
Slate			1700	1804			second show of gas 1774'
Total Depth				1804			

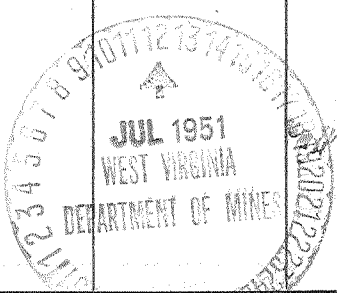

(Over)

NOV 28 1951