

New Location
 Drill Deeper
 Abandonment

Company PACK & JACKSON
 Address HAMLIN, W. VA.
 Farm J. H. MEDDERS
 Tract _____ Acres 70 Lease No. _____
 Well (Farm) No. 3 Serial No. F-1691
 Elevation (Spirit Level) 1343'
 Quadrangle CLENDENIN
 County KANAWHA District BIG SANDY
 Engineer PAUL E. JOACHIM
 Engineer's Registration No. 669
 File No. 76-63 Drawing No. _____
 Date JUNE 19, 1951 Scale 1" = 400'

STATE OF WEST VIRGINIA
 DEPARTMENT OF MINES
 OIL AND GAS DIVISION
 CHARLESTON

WELL LOCATION MAP
 FILE NO. KAN-887-A

+ Denotes location of well on United States Topographic Maps, scale 1 to 62,500, latitude and longitude lines being represented by border lines as shown.

- Denotes one inch spaces on border line of original tracing.

6-0217

J. H. MEDDERS No. 3 (F-1691) - PACK & JACKSON - KAN-887-A

J. H. MEDIERS NO. 3 WELL.

887-A

Big Sandy District, Kanawha County, W. Va.
 By Pack & Jackson, Hal Pack, Hamlin, W. Va.
 Abandoned under permit Kan-.....-A?

On 70 acres.

Elevation, 1343' L.

Drilling completed in 1913.

Shot Sept. 9, 1913, with 20 qts., at 2374-2380'; April 15, 1914,
 with 40 qts., at 2366-2380'; Nov. 15, 1915, with 30 qts., at
 2370-2380'; and Sept. 10, 1925, with 40 qts., at 2373-2380'.

8 3/4" casing, 785'; 7" O. D., 2035'; 5 1/2" T, 2140'; 2" tubing, 2380'.
 South Penn Oil Co. well.

Oil well. Record to Dept. of Mines stamped July 8, 1951.

Record to RCT from Mrs. Griffith Aug. 17, 1951. Old File No. 1571.

	Top.	Bottom.
Coal	530	- 533
Salt Sand	1300	- 1775
Big Lime	1957	- 2165
Sand	2215	- 2285
Weir Sand (oil, 2360'; oil and gas, 2376')	2318	- 2380
Total depth		2380



STATE OF WEST VIRGINIA
DEPARTMENT OF MINES
OIL AND GAS DIVISION

1571

WELL RECORD

Formerly: South Penn Oil Co.
Oil or Gas Well (KIND)


Permit No. KAN-887-A

Company Pack and Jackson
 Address o/o Hal Pack - Hamlin, W. Va.
 Farm J. H. Rodgers Acres 70
 Location (waters) _____
 Well No. 3 Elev. 1343'
 District Big Sandy County Kanawha
 The surface of tract is owned in fee by _____
 Address _____
 Mineral rights are owned by _____
 Address _____
 Drilling commenced _____
 Drilling completed 1913
 Date Shot _____ From _____ To _____
 With _____
 Open Flow _____ /10ths Water in _____ Inch
 _____ /10ths Merc. in _____ Inch
 Volume _____ Cu. Ft.
 Rock Pressure _____ lbs. _____ hrs.
 Oil _____ bbls., 1st 24 hrs.
 Fresh water _____ feet _____ feet
 Salt water _____ feet _____ feet

Casing and Tubing	Used in Drilling	Left in Well	Packers
Size			Kind of Packer
16			
13			
10			Size of
8 1/2	705	705	Depth set
6 5/8	2025	2025	
5 3/16	2140	2140	
3			Perf. top
2	2380	2380	Perf. bottom
Liners Used			Perf. top
			Perf. bottom

CASING CEMENTED _____ SIZE _____ No. Ft. _____ Date _____
 COAL WAS ENCOUNTERED AT _____ FEET _____ INCHES
 _____ FEET _____ INCHES FEET _____ INCHES
 _____ FEET _____ INCHES FEET _____ INCHES

Formation	Color	Hard or Soft	Top	Bottom	Oil, Gas or Water	Depth Found	Remarks
Coal			530	533			
Salt Sand			1500	1775			
Big Lime			1987	2165			
Sand			2215	2285			
Weir Sand			2313	2380			
Oil			2360				
Oil and Gas			2376				
Total Depth				2380			
<u>SHOT RECORD</u>							
9/9/13		20 qts	2374-2380				
4/15/14		40 qts	2366-2380				
11/15/15		30 qts	2370-2380				
9/10/25		40 qts	2373-2380				

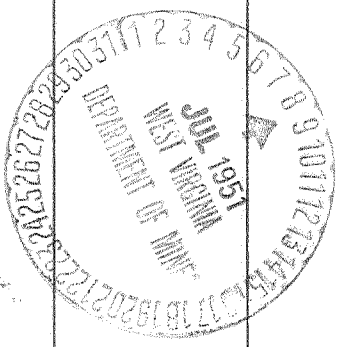

(Over) AUG 17 1951