

Company SEATEX OIL CO., INC.
 Address FALLING ROCK, W. VA.
 Farm FALLING ROCK PRODUCING CO.
 Tract _____ Acres 3240 Lease No. WEIR FEE
 Well (Farm) No. 36-80-82 Serial No. AS ABOVE
 Elevation (Spirit Level) AS ABOVE
 Quadrangle CLENDENIN
 County KANAWHA District BIG SANDY
 Engineer [Signature]
 Engineer's Registration No. 773
 File No. _____ Drawing No. _____
 Date 7-20-51 Scale 1" = 660'

STATE OF WEST VIRGINIA
 DEPARTMENT OF MINES
 OIL AND GAS DIVISION
 CHARLESTON

WELL LOCATION MAP
 FILE NO. SEE ABOVE

Blue CK 7.5

+ Denotes location of well on United States Topographic Maps, scale 1 to 62,500, latitude and longitude lines being represented by border lines as shown.

- Denotes one inch spaces on border line of original tracing.

FALLING ROCK PRODUCING CO. NO. 24 WELL.

Big Sandy District, Kanawha County, W. Va.
 By Seatex Oil Co., Inc., Falling Rock, W. Va.
 Abandoned under permit Kan-.-A?
 On 3240 acres, on Falling Rock Creek.

Elevation, 1059' L.

Drilling completed Oct. 17, 1918.

13" conductor, 10'; 8 $\frac{1}{4}$ "², 420' (pulled); 6 $\frac{5}{8}$ "², 1332'.

Oil well. Record to Dept. of Mines stamped Aug. 8, 1951.

Record to RCT from Mrs. Griffith Jan. 16, 1952. Old File No. 1620.

	Top.	Bottom.
Slate, lime, etc.	0	- 248
Coal	248	- 252
Slate, sand, slate, lime	252	- 605
Cow Run Sand (water, 690')	605	- 845
Slate	845	- 875
Sand (hole full water, 1045')	875	- 1055
Lime	1055	- 1123
Slate	1123	- 1130
Red rock	1130	- 1214
Slate and lime	1214	- 1240
Pencil Cave	1240	- 1256
Little Lime	1256	- 1296
Pencil	1296	- 1308
Big Lime (gas, 1362-1415')	1308	- 1480
Slate and shell	1480	- 1507
Weir Sand (red sand, 1570-1583'; oil, 1718-1727'; gas, 1644')	1507	- 1729
Total depth		1729

WELL PLUGGED ONE TIME & THEN DRILLED OUT AGAIN.



STATE OF WEST VIRGINIA
DEPARTMENT OF MINES
OIL AND GAS DIVISION

1670

WELL RECORD

Permit No. KAN-891-A

Oil or Gas Well _____
(KIND)

Company Sentex Oil Company, Inc.,
Address Falling Rock, W. Va.
Farm Falling Rock Producing Co Acres 3240
Location (waters) Falling Rock Creek
Well No. 94 Elev. 1059.1
District Big Sandy County Kanawha
The surface of tract is owned in fee by _____
Address _____
Mineral rights are owned by _____
Address _____

Drilling commenced _____
Drilling completed October 17, 1912
Date Shot _____ From _____ To _____
With _____

Open Flow _____ /10ths Water in _____ Inch
_____ /10ths Merc. in _____ Inch
Volume _____ Cu. Ft.
Rock Pressure _____ lbs. _____ hrs.
Oil _____ bbls., 1st 24 hrs.
Fresh water _____ feet _____ feet
Salt water _____ feet _____ feet


Casing and Tubing	Used in Drilling	Left in Well	Packers
Size			
16			Kind of Packer _____
13 Conductor	10'	10'	
10			Size of _____
8 1/4	420	420	
6 5/8	1332'	1332'	Depth set _____
5 3/16			
3			Perf. top _____
2			Perf. bottom _____
Liners Used			Perf. top _____
			Perf. bottom _____

CASING CEMENTED _____ SIZE _____ No. Ft. _____ Date _____

COAL WAS ENCOUNTERED AT _____ FEET _____ INCHES
_____ FEET _____ INCHES _____ FEET _____ INCHES
_____ FEET _____ INCHES _____ FEET _____ INCHES

Formation	Color	Hard or Soft	Top	Bottom	Oil, Gas or Water	Depth Found	Remarks
Slate, Lime, etc			---	248			
Coal			248	252			
Slate, Sand, Slate Lime			252	605			
Cow Run			605	845	Water	690'	
Slate			845	875			
Sand			875	1055	hole full water	1045'	
Lime			1055	1123			
Slate			1123	1130			
Red Rock			1130	1214			
Slate & Lime			1214	1240			
Pencil Cave			1240	1256			
Little Lime			1256	1296			
Pencil			1296	1308			
Big Lime			1308	1480	Gas	1362-1415	
Slate & Shell			1480	1507			
Weir Sand			1507	1729	Red Sand	1570'-1583'	
Total Depth				1729	Oil	1718'-1727'	
					Gas	1644'	

Well plugged one time -- then drilled out again

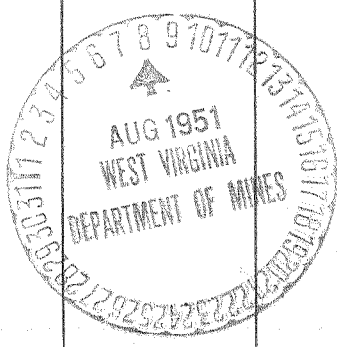

(Over)
JAN 16 1952