

COAL NOT OPERATED

- ✓ KAN-890-A-#21
- ✓ KAN-891-A-#24
- ✓ KAN-892-A-#29
- ✓ KAN-893-A-#36
- ✓ KAN-894-A-#80
- ✓ KAN-895-A-#82

FEB 1 1953

Company SEATEX OIL CO., INC.  
 Address FALLING ROCK, W. VA.  
 Farm FALLING ROCK PRODUCING CO.  
 Tract \_\_\_\_\_ Acres 3240 Lease No. WEIR FEE  
 Well (Farm) No. 36-80-82 Serial No. AS ABOVE  
 Elevation (Spirit Level) AS ABOVE  
 Quadrangle CLENDENIN  
 County KANAWHA District BIG SANDY  
 Engineer [Signature]  
 Engineer's Registration No. 773  
 File No. \_\_\_\_\_ Drawing No. \_\_\_\_\_  
 Date 7-20-51 Scale 1" = 660'

STATE OF WEST VIRGINIA  
 DEPARTMENT OF MINES  
 OIL AND GAS DIVISION  
 CHARLESTON

WELL LOCATION MAP

FILE NO. SEE ABOVE

+ Denotes location of well on United States Topographic Maps, scale 1 to 62,500, latitude and longitude lines being represented by border lines as shown.

- Denotes one inch spaces on border line of original tracing.

FALLING ROCK PRODUCING CO. NO. 36 WELL.

Big Sandy District, Kanawha County, W. Va.

By Seatech Oil Co., Inc., Falling Rock, W. Va.

Abandoned under permit Kan-.....-A?

On 3240 acres, on Falling Rock Creek.

Elevation, 798.6' L.

Date of completion, etc., not given.

10" casing, 29-5/8"; 8 1/2", 510'; 6 3/4", 1456'; all left in.

Oil well. Record to Dept. of Mines stamped Aug. 9, 1951.

Record to RCT from Mrs. Griffith Jan. 16, 1952. Old File No. 1621.

	Top.	Bottom.
Shale	0	23
Sand	23	100
Slate	100	200
Sandy lime	200	245
Slate	245	442
Sandy lime	442	460
Slate	460	600
Lime	600	670
Salt Sand (1st water, 815'; hole filled up, 890')	670	900
Lime	900	1020
Sand	1020	1125
Slate	1125	1130
Lime	1130	1175
Slate	1175	1185
Red rock	1185	1200
Slate	1200	1210
Red rock	1210	1253
White slate	1253	1270
Red rock	1270	1290
Slate	1290	1295
Maxton Sand	1295	1315
Slate	1315	1332
Little Lime	1332	1372
Slate	1372	1378
Shells and slate	1378	1401
Big Lime (gas, 1515')	1401	1562
Slate	1562	1590
Weir Sand ( <del>hardly permeable</del> )	1590	1803 (1608?)
Red sand	1645	1647

(Last line only partially printed a/c position of carbon paper. May be other items to follow. Check on this).



STATE OF WEST VIRGINIA  
DEPARTMENT OF MINES  
OIL AND GAS DIVISION

1521

WELL RECORD

Permit No. KAN-893-A

Oil or Gas Well (KIND)


Company Seatex Oil Company, Inc.,  
Address Falling Rock, W. Va.  
Farm Falling Rock Producing Corp. Acres 3240  
Location (waters) Falling Rock Creek  
Well No. 36 Elev. 798.6'  
District Big Sandy County Kanawha  
The surface of tract is owned in fee by \_\_\_\_\_  
Address \_\_\_\_\_  
Mineral rights are owned by \_\_\_\_\_  
Address \_\_\_\_\_

Casing and Tubing	Used in Drilling	Left in Well	Packers
Size			
16			Kind of Packer
13			
10			Size of
8 1/4	<u>29-5/8'</u> <u>510'</u>	<u>29-5/8'</u> <u>510'</u>	
6 5/8	<u>1456'</u>	<u>1456'</u>	Depth set
5 3/16			
3			Perf. top
2			Perf. bottom
Liners Used			Perf. top
			Perf. bottom

Drilling commenced \_\_\_\_\_  
Drilling completed \_\_\_\_\_  
Date Shot \_\_\_\_\_ From \_\_\_\_\_ To \_\_\_\_\_  
With \_\_\_\_\_  
Open Flow \_\_\_\_\_ /10ths Water in \_\_\_\_\_ Inch  
\_\_\_\_\_ /10ths Merc. in \_\_\_\_\_ Inch  
Volume \_\_\_\_\_ Cu. Ft.  
Rock Pressure \_\_\_\_\_ lbs. \_\_\_\_\_ hrs.  
Oil \_\_\_\_\_ bbls., 1st 24 hrs.  
Fresh water \_\_\_\_\_ feet \_\_\_\_\_ feet  
Salt water \_\_\_\_\_ feet \_\_\_\_\_ feet

CASING CEMENTED \_\_\_\_\_ SIZE \_\_\_\_\_ No. Ft. \_\_\_\_\_ Date \_\_\_\_\_  
COAL WAS ENCOUNTERED AT \_\_\_\_\_ FEET \_\_\_\_\_ INCHES  
\_\_\_\_\_ FEET \_\_\_\_\_ INCHES FEET \_\_\_\_\_ INCHES  
\_\_\_\_\_ FEET \_\_\_\_\_ INCHES FEET \_\_\_\_\_ INCHES

Formation	Color	Hard or Soft	Top	Bottom	Oil, Gas or Water	Depth Found	Remarks
Shale				23			
Sand			23	100			
Slate			100	200			
Sandy Lime			200	245			
Slate			245	442			
Sandy Lime			442	460			
Slate			460	600			
Lime			600	670			
Salt Sand			670	900			1st water 815' - hole filled up 890'
Lime			900	1020			
Sand			1020	1125			
Slate			1125	1130			
Lime			1130	1175			
Slate			1175	1185			
Red Rock			1185	1200			
Slate			1200	1210			
Red Rock			1210	1253			
White Slate			1253	1270			
Red Rock			1270	1290			
Slate			1290	1295			
Maxon Sand			1295	1315			
Slate			1315	1332			
Little Lime			1332	1372			
Slate			1372	1378			
Shells & Slate			1378	1401			
Big Lime			1401	1562			Gas in Lime 1515'
Slate			1562	1590			
Weir Sand			1590	1608 @ (1608')			
Sand			1608	1647			

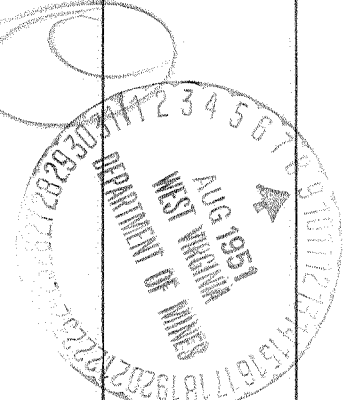

(Over)  
JAN 16 1952