

Company SEATEX OIL CO., INC.
 Address FALLING ROCK, W. VA.
 Farm FALLING ROCK PRODUCING CO.
 Tract _____ Acres 3240 Lease No. WEIR FEE
 Well (Farm) No. 36-80-82 Serial No. AS ABOVE
 Elevation (Spirit Level) AS ABOVE
 Quadrangle CLENDENIN
 County KANAWHA District BIG SANDY
 Engineer [Signature]
 Engineer's Registration No. 773
 File No. _____ Drawing No. _____
 Date 7-20-51 Scale 1" = 660'

STATE OF WEST VIRGINIA
 DEPARTMENT OF MINES
 OIL AND GAS DIVISION
 CHARLESTON

WELL LOCATION MAP

FILE NO. SEE ABOVE

Blue CK 7.5
 + Denotes location of well on United States Topographic Maps, scale 1 to 62,500, latitude and longitude lines being represented by border lines as shown.

- Denotes one inch' spaces on border line of original tracing.

FALLING ROCK PRODUCING CO. NO. 80 WELL.

Big Sandy District, Kanawha County, W. Va.

By Seatek Oil Co., Inc., Falling Rock, W. Va.

Abandoned under permit Kan-.....-A?

On 3240 acres, on Falling Rock Creek.

Elevation, 750' L.

Drilling completed Nov. 26, 1918.

10" casing (conductor), 1 1/4"; 8 1/2", 320' (pulled); 6 5/8", 1567'; 5 1/2", 1567'.

Oil well. Record to Dept. of Mines stamped Aug. 9, 1951.

Record to RPT from Mrs. Griffith Nov. 28, 1951. Old File No. 1597.

	Top.	Bottom.
Various.....	0	1563
Big Line	1563	1745
Black slate	1745	1755
Big Injun Sand	1755	1777
Weir Sand (1st gas, 1812'; 2nd gas, 1936'; black oil, 1962'; green oil, 1986'; 3rd gas, 1972')	1777	1986
Slate	1986	2002
Total depth		2002



STATE OF WEST VIRGINIA
DEPARTMENT OF MINES
OIL AND GAS DIVISION

1597

Permit No. KAN-894-A

WELL RECORD

Oil or Gas Well _____ (KIND)


Company Sexton Oil Company, Inc.
Address Falling Rock, W. Va.
Farm Falling Rock Producing Co. Acres 3240
Location (waters) Falling Rock Creek
Well No. 90 Elev. 750.1
District Big Sandy County Kanawha
The surface of tract is owned in fee by _____
Address _____
Mineral rights are owned by _____
Address _____
Drilling commenced _____
Drilling completed November 26, 1913
Date Shot _____ From _____ To _____
With _____
Open Flow _____ /10ths Water in _____ Inch
_____ /10ths Merc. in _____ Inch
Volume _____ Cu. Ft.
Rock Pressure _____ lbs. _____ hrs.
Oil _____ bbls., 1st 24 hrs.
Fresh water _____ feet _____ feet
Salt water _____ feet _____ feet

Casing and Tubing	Used in Drilling	Left in Well	Packers
Size			Kind of Packer
16			
13			
10	<u>conductor 21'</u>	<u>21'</u>	Size of
8 1/4	<u>380</u>	<u>pulled</u>	Depth set
6 3/4	<u>1567</u>	<u>1567</u>	
5 3/16	<u>1567</u>	<u>1567</u>	
3			Perf. top
2			Perf. bottom
Liners Used			Perf. top
			Perf. bottom

CASING CEMENTED _____ SIZE _____ No. Ft. _____ Date _____

COAL WAS ENCOUNTERED AT _____ FEET _____ INCHES
_____ FEET _____ INCHES _____ FEET _____ INCHES
_____ FEET _____ INCHES _____ FEET _____ INCHES

Formation	Color	Hard or Soft	Top	Bottom	Oil, Gas or Water	Depth Found	Remarks
Various				1563			
Big Lime			1563	1745			
Black Slate			1745	1755			
Injun			1755	1777			
Weir			1777	1986			
Slate			1986	2002			
Total Depth				2002			
					1st Gas	1812'	
					2nd Gas	1936	
					Black Oil	1962	
					Green Oil	1986	
					3rd Gas	1972	

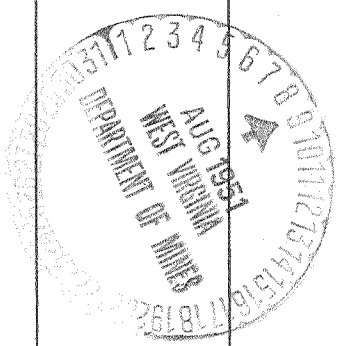

C

(Over)

NOV 28 1951