

Company VALLEY STEEL PRODUCTS CO.  
 Address ST. LOUIS, MISSOURI  
 Farm BLUE CREEK TRACT  
 Tract Acres 29,768 Lease No. 57,822  
 Well (Farm) No. 17 Serial No. F-1467  
 Elevation (Spirit Level) 1105'  
 Quadrangle CLENDENIN  
 County KANAWHA District ELK  
 Engineer PAUL E. JOACHIM  
 Engineer's Registration No. 669  
 File No. 74-61-63 Drawing No. \_\_\_\_\_  
 Date APRIL 14, 1951 Scale 1" = 400'

STATE OF WEST VIRGINIA  
 DEPARTMENT OF MINES  
 OIL AND GAS DIVISION  
 CHARLESTON

WELL LOCATION MAP  
 FILE NO. KAN-898-A

+ Denotes location of well on United States Topographic Maps, scale 1 to 62,500, latitude and longitude lines being represented by border lines as shown.

- Denotes one inch spaces on border line of original tracing.

6-0-218

BLUE CREEK TRACT NO. 17 (F-1467) - VALLEY STEEL PRODUCTS Co. - KAN-898-A

BLUE CREEK TRACT NO. 17 WELL.

655A

Elk District, Kanawha County, W. Va.  
By Valley Steel Products Co., St. Louis, Mo.  
Abandoned under permit Kan-.....-A?  
On 29,768 acres.  
Elevation, 1105' L.  
Date of completion, etc., not given.  
8 1/2" casing, 660'; 6 3/4", 1748'; 5 1/2", 1790'; all left in.  
Coal was encountered at 285-290 and 395-405'.  
Oil well. Record to Dept. of Mines stamped Aug. 13, 1951.  
Record to RCT from Mrs. Griffith Jan. 16, 1952. Old File No. 1617.

	Top.	Bottom.
Coal	285	- 290
Coal	395	- 405
Salt Sand	1010	- 1478
Little Lime	1683	- 1728
Pencil Cave	1728	- 1730
Big Lime	1730	- 1915
Weir Sand	2032	- 2115
Total depth		2115



1617

STATE OF WEST VIRGINIA  
DEPARTMENT OF MINES  
OIL AND GAS DIVISION

WELL RECORD

Permit No. KAW-898-A

Oil or Gas Well \_\_\_\_\_  
(KIND)


Company Valley Steel Products Company  
Address Saint Louis, Mo.  
Farm Blue Creek Tract Acres 29,768  
Location (waters) \_\_\_\_\_  
Well No. 17 Elev. 1105'  
District Elk County Kanawha  
The surface of tract is owned in fee by \_\_\_\_\_  
Address \_\_\_\_\_  
Mineral rights are owned by \_\_\_\_\_  
Address \_\_\_\_\_

Casing and Tubing	Used in Drilling	Left in Well	Packers
Size			
16			Kind of Packer
13			
10			Size of
8 1/4	660'	660'	
6 5/8	1748'	1748'	Depth set
5 3/16	1790'	1790'	
3			Perf. top
2			Perf. bottom
Liners Used			Perf. top
			Perf. bottom

Drilling commenced \_\_\_\_\_  
Drilling completed \_\_\_\_\_  
Date Shot \_\_\_\_\_ From \_\_\_\_\_ To \_\_\_\_\_  
With \_\_\_\_\_  
Open Flow \_\_\_\_\_ /10ths Water in \_\_\_\_\_ Inch  
\_\_\_\_\_ /10ths Merc. in \_\_\_\_\_ Inch  
Volume \_\_\_\_\_ Cu. Ft.  
Rock Pressure \_\_\_\_\_ lbs. \_\_\_\_\_ hrs.  
Oil \_\_\_\_\_ bbls., 1st 24 hrs.  
Fresh water \_\_\_\_\_ feet \_\_\_\_\_ feet  
Salt water \_\_\_\_\_ feet \_\_\_\_\_ feet

CASING CEMENTED \_\_\_\_\_ SIZE \_\_\_\_\_ No. Ft. \_\_\_\_\_ Date \_\_\_\_\_  
COAL WAS ENCOUNTERED AT \_\_\_\_\_ FEET \_\_\_\_\_ INCHES  
285  
395 FEET \_\_\_\_\_ INCHES FEET \_\_\_\_\_ INCHES  
FEET \_\_\_\_\_ INCHES FEET \_\_\_\_\_ INCHES

Formation	Color	Hard or Soft	Top	Bottom	Oil, Gas or Water	Depth Found	Remarks
Coal			285	290			
Coal			395	405			
Salt Sand			1010	1478			
Little Lime			1683	1728			
Pencil Cave			1728	1730			
Big Lime			1730	1915			
Weir Sand			2032	2115			
TOTAL DEPTH				2115			

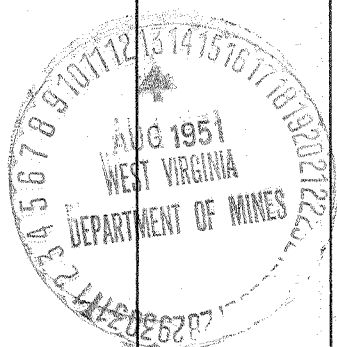

JAN 6 1952  
(Over)