

Company VALLEY STEEL PRODUCTS Co.

Address ST. LOUIS, MISSOURI

Farm OWENS-ILLINOIS GLASS Co.

Tract _____ Acres 32 Lease No. _____

Well (Farm) No. 1 & 2 Serial No. F-4584

Elevation (Spirit Level) #1-606.56, #2-608.32

Quadrangle CHARLESTON

County KANAWHA District LOUDON

Engineer PAUL E. JOACHIM

Engineer's Registration No. 669

File No. 64-55 Drawing No. _____

Date AUGUST 25, 1951 Scale 1"=500'

STATE OF WEST VIRGINIA
 DEPARTMENT OF MINES
 OIL AND GAS DIVISION
 CHARLESTON

WELL LOCATION MAP
 FILE NO. KAN-901-A-#2
KAN-902-A-#1

+ Denotes location of well on United States Topographic Maps, scale 1 to 62,500, latitude and longitude lines being represented by border lines as shown.

- Denotes one inch spaces on border line of original tracing.

OWENS BOTTLE CO. NO. 2 WELL.

(50-41)

9018

Loudon District, Kanawha County, W. Va.
 By Valley Steel Products Co., St. Louis, Mo.
 Abandoned under permit Kan-.....-A?
 On ~~6000000000~~ acres.
 Elevation, 608.32' L.
 Drilling commenced Dec. 10, 1919; completed Feb. 4, 1920.
 Well was not shot.
 Volume, 5,600,000 cu. ft.
 Rock pressure, 375 lbs. in 24 hrs.
 Fresh water, 190'; hole full, 515 - 745'.
 10" casing, 63'; 8 1/4", 683' (pulled); 6 5/8", 1195'; 2" tubing, 1700'.
 Anchor packer, 6 5/8 x 2 x 16, set at 1215'.
 Gas, 1082'. Gas, 1230', 200 M.; gas, 1425', 180 M.; gas, 1515',
 275 M.; gas, 1592', 350 M.; gas, 1608', 175 M. cu. ft.
 Gas well. Record to Dept. of Mines stamped Aug. 16, 1951.
 Record to RCT from Mrs. Griffith Jan. 16, 1952. Old File No. 1630.

	Top.	Bottom.
Surface	0	40
Sand and gravel	40	60
Sand	60	95
Slate	95	115
Sand	115	155
Slate	155	180
Sand	180	275
Slate	275	282
Sand	282	310
Slate	310	330
Sand	330	445
Slate and shells	445	475
Salt Sand	475	740
Slate	740	743
Coal	743	747
Sand	747	800
Slate	800	825
Sand	825	945
Slate and shells	945	965
Maxton Sand	965	1015
Little Lime	1015	1042
Pencil Cave	1042	1050
Lime shell	1050	1060
2nd Pencil Cave	1060	1074
Big Lime	1074	1250
Big Injun Sand	1250	1280
Slate	1280	1285
Big Injun Sand	1285	1305
Slate and shells	1305	1565
Shells	1565	1675
Coffee Shale	1675	1688
Berea Grit	1688	1693
Slate and shells	1693	1700
Total depth		1700



STATE OF WEST VIRGINIA
DEPARTMENT OF MINES
OIL AND GAS DIVISION

1630

2222

WELL RECORD

Permit No. 901-A

Oil or Gas Well GAS
(KIND)


Company Valley Steel Products Company
Address St. Louis, Missouri
Farm Coca Bottle Company Acres _____
Location (waters) _____
Well No. 2 Elev. 606.32
District Louisa County Monroe
The surface of tract is owned in fee by _____
Address _____
Mineral rights are owned by _____
Address _____
Drilling commenced December 10, 1919
Drilling completed February 4, 1920
Date Shot Not shot From _____ To _____
With _____
Open Flow _____ /10ths Water in _____ Inch
_____ /10ths Merc. in _____ Inch
Volume 5,600,000 Cu. Ft.
Rock Pressure 375 lbs. 26 hrs.
Oil _____ bbls., 1st 24 hrs.
Fresh water 130' feet 515' - 745' feet
Salt water _____ feet _____ feet

Casing and Tubing	Used in Drilling	Left in Well	Packers
Size			
16			Kind of Packer <u>Anchor</u>
13			
10	<u>63'</u>	<u>63'</u>	Size of <u>6-5/8" x 2</u>
8 1/4	<u>633'</u>	<u>611'</u>	<u>x 26</u>
6 5/8	<u>1195'</u>	<u>1195'</u>	Depth set <u>1215'</u>
5 3/16			
3			Perf. top _____
2	<u>1700'</u>	<u>1700'</u>	Perf. bottom _____
Liners Used			Perf. top _____
			Perf. bottom _____

CASING CEMENTED _____ SIZE _____ No. Ft. _____ Date _____

COAL WAS ENCOUNTERED AT _____ FEET _____ INCHES
_____ FEET _____ INCHES FEET _____ INCHES
_____ FEET _____ INCHES FEET _____ INCHES

Formation	Color	Hard or Soft	Top	Bottom	Oil, Gas or Water	Depth Found	Remarks
Surface			0	40			
Sand and gravel			40	60			
Sand			60	95			
Slate			95	115			
Sand			115	155			
Slate			155	180			
Sand			180	275			
Slate			275	332			
Sand			332	310			
Slate			310	330			
Sand			330	445		Gas 1082'	
Slate and shells			445	475		Gas 1230'	210 HCF
Silt sand			475	740		Gas 1425'	150 HCF
Slate			740	743		Gas 1515'	275 HCF
Coal			743	747		Gas 1592'	350 HCF
Sand			747	810		Gas 1608'	175 HCF
Slate			810	835			
Sand			835	945			
Slate and shells			945	965			
Horton sand			965	1015			
Little line			1015	1042			
Pencil con			1042	1050			
Line shell			1050	1060			
2nd Pencil con			1060	1074			
Big line			1074	1250			
Injun sand			1250	1280			
Slate			1280	1385			
Injun sand			1385	1395			
Slate and shells			1395	1565			
Shells			1565	1675			
Coffee shale			1675	1680			
Brown grit			1680	1693			
Slate and shells			1693	1700			
Total Depth				1700			

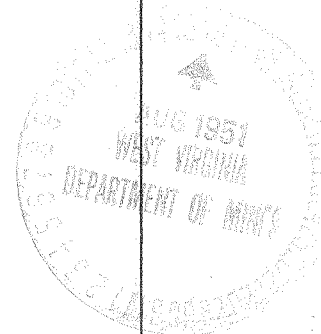

JAN 16 1951
(Over)