

New Location

Drill Deeper

Abandonment

Company KREBS OIL CO., INC.

Address CHAS. NAT. BANK BLDG. CHAS. W. VA

Farm H.V. KINGSLEY

Tract 1 Acres 30 Lease No. _____

Well (Farm) No. 3 Serial No. 3202

Elevation (Spirit Level) 842

Quadrangle CLENDENIN

County KANAWHA District ELK

Engineer C. H. Krebs

Engineer's Registration No. 773

File No. _____ Drawing No. _____

Date 9-6-51 Scale 1" = 400'

STATE OF WEST VIRGINIA
DEPARTMENT OF MINES
OIL AND GAS DIVISION
CHARLESTON

WELL LOCATION MAP
FILE NO. KRN-905-A

+ Denotes location of well on United States Topographic Maps, scale 1 to 62,500, latitude and longitude lines being represented by border lines as shown.

- Denotes one inch spaces on border line of original tracing.

H.V. KINGSLEY No. 3 (3202) - KREBS OIL CO., INC. - KRN-905-A

H. V. KINGSLEY NO. 3 WELL.

905A

Elk District, Kanawha County, W. Va.

By Krebs Oil Co., Box 213, Charleston, W. Va.

Abandoned under permit Kan-.....-A?

On 30 acres, on Indian Creek.

Elevation, 842' L.

Surface and minerals owned by Mrs. Nora Vickers, Pinch, W. Va.

Drilling commenced Sept. 17, 1915; completed Nov. 8, 1915.

8 $\frac{1}{4}$ " casing, 415' (pulled); 6 $\frac{5}{8}$ "", 1420'.

Oil well. Record to Dept. of Mines stamped Sept. 17, 1951.

Record to RCT from Mrs. Griffith Feb. 29, 1952. Old File No. 1644.

	Top.	Bottom.
Sand	0	100
Slate and shells	100	140
Sand	140	200
Slate	200	290
Sand	290	330
Slate	330	360
Sand	360	415
Slate	415	675
Salt Sand	675	1190
Slate	1190	1200
Lime	1200	1260
Sand	1260	1280
Red rock	1280	1290
Slate	1290	1300
Lime shells	1300	1354
Little Lime	1354	1384
Slate	1384	1390
Lime	1390	1405
Slate	1405	1410
Lime	1410	1412
Pencil Cave	1412	1415
Big Lime	1415	1578
Slate	1578	1620
Weir Sand	1620	1824
Total depth		1843



STATE OF WEST VIRGINIA
DEPARTMENT OF MINES
OIL AND GAS DIVISION

1644

WELL RECORD

Oil or Gas Well _____
(KIND)


Permit No. KAN-905-A

Company Krebs Oil Company
Address Box No. 213
Farm H. V. Kingsley Acres 30
Location (waters) Indian Creek
Well No. 5 Elev. 842
District Elk County Kanawha
The surface of tract is owned in fee by Mrs. Nora Vickers
Address Pinch, W. Va.
Mineral rights are owned by Mrs. Nora Vickers
Address Pinch, W. Va.
Drilling commenced September 17, 1915
Drilling completed November 8, 1915
Date Shot From _____ To _____
With _____
Open Flow /10ths Water in _____ Inch
/10ths Merc. in _____ Inch
Volume _____ Cu. Ft.
Rock Pressure _____ lbs. _____ hrs.
Oil _____ bbls., 1st 24 hrs.
Fresh water _____ feet _____ feet
Salt water _____ feet _____ feet

Casing and Tubing	Used in Drilling	Left in Well	Packers
Size			Kind of Packer
16			
13			
10			Size of
8 1/4	415'		
6 5/8	1420'	1420'	Depth set
5 3/16			
3			Perf. top
2			Perf. bottom
Liners Used			Perf. top
			Perf. bottom

CASING CEMENTED _____ SIZE _____ No. Ft. _____ Date _____
COAL WAS ENCOUNTERED AT _____ FEET _____ INCHES
_____ FEET _____ INCHES _____ FEET _____ INCHES
_____ FEET _____ INCHES _____ FEET _____ INCHES

Formation	Color	Hard or Soft	Top	Bottom	Oil, Gas or Water	Depth Found	Remarks
Sand				100			
Slate and Shells			100	140			
Sand			140	200			
Slate			200	290			
Sand			290	330			
Slate			330	360			
Sand			360	415			
Slate			415	675			
Salt Sand			675	1190			
Slate			1190	1200			
Lime			1200	1260			
Sand			1260	1280			
Red Rock			1280	1290			
Slate			1290	1300			
Lime Shells			1300	1354			
Little Lime			1354	1384			
Slate			1384	1390			
Lime			1390	1405			
Slate			1405	1410			
Lime			1410	1412			
Pencil Cave			1412	1415			
Big Lime			1415	1578			
Slate			1578	1620			
Sand - Weir			1620	1824			
TOTAL DEPTH				1843'			

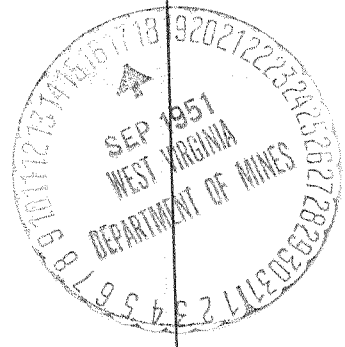

FEB 29 1952
(Over)