

New Location
 Drill Deeper
 Abandonment

(1951)

FEB 1 1953

0.5 W
 V.4 Q

Company KREBS OIL CO., INC.
 Address CHAS. NATIONAL BANK BLDG.,
 Farm EDWARD GEBHART CHAS. W. VA.
 Tract _____ Acres 900 Lease No. 881
 Well (Farm) No. 4 Serial No. 3119
 Elevation (Spirit Level) 892
 Quadrangle CLENDENIN
 County KANAWHA District ELK
 Engineer R. H. Krebs
 Engineer's Registration No. 773
 File No. _____ Drawing No. _____
 Date 10-20-51 Scale 1"=1320'

STATE OF WEST VIRGINIA
 DEPARTMENT OF MINES
 OIL AND GAS DIVISION
 CHARLESTON

WELL LOCATION MAP
 FILE NO. KAN-913-A

+ Denotes location of well on United States Topographic Maps, scale 1 to 62,500, latitude and longitude lines being represented by border lines as shown.

- Denotes one inch spaces on border line of original tracing.

6-0 217

EDWARD GEBHART NO. 4 (3119) - KREBS OIL CO., INC. - KAN-913-A

EDWARD GEBHART NO. 4 WELL.

Blk District, Kanawha County, W. Va.
 By Valley Steel Products Co., St. Louis, Mo.
 Abandoned under permit Kan-.....-A?
 On 900 acres, on Blue Creek.
 Elevation, 892' L.
 Drilling commenced Nov. 14, 1914; completed Dec. 30, 1914.
 8 1/2" casing, 691' (120' left in); 6 3/8", 1553'.
 Oil well. Record to Dept. of Mines stamped Nov. 2, 1951.
 Record to RCT from Mrs. Griffith Jan. 16, 1952. Old File No. 1623.

	Top.	Bottom.
Clay	0	16
Sand	16	190
Coal	190	193
Slate	193	200
Sand	200	260
Slate	260	360
Sand	360	420
Slate	420	440
Sand	440	500
Slate	500	530
Sand	530	630
Slate	630	670
Coal (water, 670')	670	671
Slate	671	850
Salt Sand (water, 925'; HPW, 960')	850	1365
Slate	1365	1370
Lime	1370	1380
Red rock	1380	1390
Slate	1390	1415
Lime	1415	1425
Red rock	1425	1440
Slate	1440	1460
Maxton Sand	1460	1493
Little Lime	1493	1525
Slate	1525	1530
Lime	1530	1535
Slate	1535	1545
Lime	1545	1548
Pencil Cave	1548	1551
Big Lime	1551	1706
Slate	1706	1726
Red rock	1726	1750
Slate	1750	1760
Lime	1760	1775
Weir Sand (gas, 1849'; more gas, 1938'; first oil, 1938')	1775	1950
Total depth		1950



STATE OF WEST VIRGINIA
DEPARTMENT OF MINES
OIL AND GAS DIVISION

1523

WELL RECORD

Permit No. KAW-913-A Oil or Gas Well _____ (KIND)

Company Valley Steel Products Company
Address St. Louis, Mo.
Farm Edward Gebhart Acres 900
Location (waters) Blue Creek
Well No. 4 Elev. 892'
District 11k County Kanawha
The surface of tract is owned in fee by _____
Address _____
Mineral rights are owned by _____
Address _____
Drilling commenced November 14, 1914
Drilling completed December 30, 1914
Date Shot From _____ To _____
With _____
Open Flow /10ths Water in _____ Inch
/10ths Merc. in _____ Inch
Volume _____ Cu. Ft.
Rock Pressure _____ lbs. _____ hrs.
Oil _____ bbls., 1st 24 hrs.
Fresh water _____ feet _____ feet
Salt water _____ feet _____ feet

Casing and Tubing	Used in Drilling	Left in Well	Packers
Size			
16			Kind of Packer
18			
10			Size of
8 1/4	691	120	
6 3/8	1553	1553	Depth set
5 3/16			
3			Perf. top
2			Perf. bottom
Liners Used			Perf. top
			Perf. bottom


CASING CEMENTED _____ SIZE _____ No. Ft. _____ Date _____

COAL WAS ENCOUNTERED AT _____ FEET _____ INCHES
_____ FEET _____ INCHES _____ FEET _____ INCHES
_____ FEET _____ INCHES _____ FEET _____ INCHES

Formation	Color	Hard or Soft	Top	Bottom	Oil, Gas or Water	Depth Found	Remarks
Clay				16			
Sand			16	190			
Coal			190	193			
Slate			193	200			
Sand			200	260			
Slate			260	360			
Sand			360	420			
Slate			420	440			
Sand			440	500			
Slate			500	530			
Sand			530	630			
Slate			630	670			
Coal			670	671			
Slate			671	850			
Salt Sand			850	1365			
Slate			1365	1370			
Lime			1370	1380			
Red Rock			1380	1390			
Slate			1390	1415			
Lime			1415	1425			
Red Rock			1425	1440			
Slate			1440	1460			
Maxon Sand			1460	1493			
Little Lime			1493	1525			
Slate			1525	1530			
Slate Lime			1530	1535			
Slate			1535	1545			
Lime			1545	1548			
Pencil Cave			1548	1551			
Big Lime			1551	1706			
Slate			1706	1726			
Red Rock			1726	1750			
Slate			1750	1760			
Lime			1760	1775			
Weir Sand			1775	1950			
Total Depth				1950			

Water 670'
Water 925'
hole full of water 960'

Gas 1849'
More Gas 1938'
First Oil 1938'

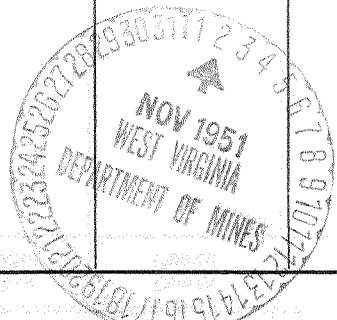

JAN 16 1952