

Company KREBS OIL CO., INC.

Address CHARLESTON NAT. BANK BLDG.

Farm W. D. LEWIS CHAS. W. VA.

Tract \_\_\_\_\_ Acres 615 Lease No. \_\_\_\_\_

Well (Farm) No. 28 Serial No. 1261

Elevation (Spirit Level) 960'

Quadrangle CHARLESTON

County KANAWHA District ELK

Engineer E. L. Krebs

Engineer's Registration No. 773

File No. \_\_\_\_\_ Drawing No. \_\_\_\_\_

Date 10-18-51 Scale 1" = 1000'

STATE OF WEST VIRGINIA  
DEPARTMENT OF MINES  
OIL AND GAS DIVISION  
CHARLESTON

WELL LOCATION MAP  
FILE NO. KAN-916-A

+ Denotes location of well on United States Topographic Maps, scale 1 to 62,500, latitude and longitude lines being represented by border lines as shown.

- Denotes one inch spaces on border line of original tracing.

6-0 2-18

W. D. LEWIS (NAVAJO) NO. 8 WELL.

Elk District, Kenawha County, W. Va.  
 By Krebs Oil Co., Box 213, Charleston, W. Va.  
 Abandoned under permit Kan-----A?  
 On 500 acres, on Mill Creek.  
 Elevation, 960' L.  
 Drilling commenced May 28, 1917; completed July 25, 1917.  
 8" casing, 480' (pulled); 6", 1566'.  
 Oil well. Record to Dept. of Mines stamped Nov. 10, 1951.  
 Record to ROT from Mrs. Griffith Jan. 16, 1952. Old File No. 1625.

	Top.	Bottom.
Surface	0	10
Sand	10	60
Slate	60	110
Lime	110	130
Slate	130	155
Sand	155	200
Sand	200	225
Slate	225	245
Sand	245	290
Slate	290	335
Sand	335	380
Slate	380	430
Sand	430	470
Slate	470	486
Sand	486	525
Slate and shells	525	695
Gas Sand	695	750
Salt Sand	750	1050
Slate	1050	1070
Sand	1070	1090
Lime	1090	1120
Sand, bottom Salt	1120	1315
Lime	1315	1330
Slate	1330	1445
Red rock	1445	1455
Slate	1455	1465
Merton Sand	1465	1480
Slate	1480	1500
Little Lime	1500	1525
Slate	1525	1528
Lime shell	1528	1533
Pencil Cave	1533	1537
Big Lime	1537	1718
Slate	1718	1722
Big Injun Sand	1722	1732
Red rock	1732	1752
Slate and shell	1752	1825
Weir Sand	1825	1963
Slate	1963	1984
Total depth		1984



STATE OF WEST VIRGINIA  
DEPARTMENT OF MINES  
OIL AND GAS DIVISION

1625

WELL RECORD

Permit No. KAN-916-A

Oil or Gas Well \_\_\_\_\_  
(KIND)

Company Krebs Oil Company  
Address Box #213, Charleston, W. Va.  
Farm W. D. Lewis (Navajo) Acres 500  
Location (waters) Mill Creek  
Well No. 8 Elev. 960  
District Elk County Kanawha

The surface of tract is owned in fee by W. D. Lewis  
Address Charleston, W. Va.

Mineral rights are owned by \_\_\_\_\_  
Address \_\_\_\_\_

Drilling commenced May 28, 1917

Drilling completed July 25, 1917

Date Shot \_\_\_\_\_ From \_\_\_\_\_ To \_\_\_\_\_

With \_\_\_\_\_

Open Flow \_\_\_\_\_ /10ths Water in \_\_\_\_\_ Inch

\_\_\_\_\_ /10ths Merc. in \_\_\_\_\_ Inch

Volume \_\_\_\_\_ Cu. Ft.

Rock Pressure \_\_\_\_\_ lbs. \_\_\_\_\_ hrs.

Oil \_\_\_\_\_ bbls., 1st 24 hrs.

Fresh water \_\_\_\_\_ feet \_\_\_\_\_ feet

Salt water \_\_\_\_\_ feet \_\_\_\_\_ feet

Casing and Tubing	Used in Drilling	Left in Well	Packers
Size			Kind of Packer
16			
18			
10			Size of
8 1/2	480'		
6 3/8	1566'	1566'	Depth set
5 3/16			
3			Perf. top
2			Perf. bottom
Liners Used			Perf. top
			Perf. bottom



CASING CEMENTED \_\_\_\_\_ SIZE \_\_\_\_\_ No. Ft. \_\_\_\_\_ Date \_\_\_\_\_

COAL WAS ENCOUNTERED AT \_\_\_\_\_ FEET \_\_\_\_\_ INCHES

\_\_\_\_\_ FEET \_\_\_\_\_ INCHES \_\_\_\_\_ FEET \_\_\_\_\_ INCHES

\_\_\_\_\_ FEET \_\_\_\_\_ INCHES \_\_\_\_\_ FEET \_\_\_\_\_ INCHES

Formation	Color	Hard or Soft	Top	Bottom	Oil, Gas or Water	Depth Found	Remarks
Surface				10			
Sand			10	60			
Slate			60	110			
Lime			110	130			
Slate			130	155			
Sand			155	200			
Sand			200	225			
Slate			225	245			
Sand			245	290			
Slate			290	335			
Sand			335	380			
Slate			380	430			
Sand			430	470			
Slate			470	486			
Sand			486	525			
Slate and Shells			525	695			
Gas Sand			695	750			
Salt Sand			750	1050			
Slate			1050	1070			
Sand			1070	1090			
Lime			1090	1120			
Sand, bottom Salt			1120	1315			
Lime			1315	1330			
Slate			1330	1445			
Red Rock			1445	1455			
Slate			1455	1465			
Maxon sand			1465	1480			
Slate			1480	1500			
Little Lime			1500	1525			
Slate			1525	1528			
Lime Shell			1528	1533			
Pencil Cave			1533	1537			
Big Lime			1537	1718			
Slate			1718	1722			
Big Injun			1722	1732			
Red Rock			1732	1752			
Slate and Shell			1752	1825			
Weir			1825	1963			
Slate			1963	1984			
					TOTAL DEPTH	- - -	1984'

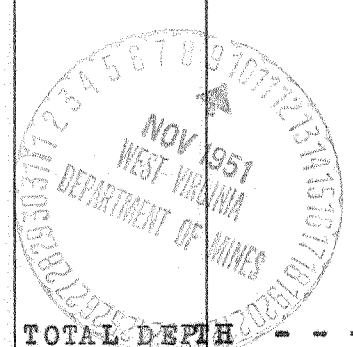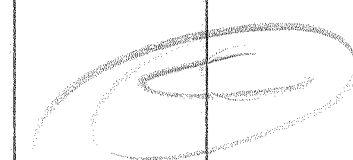

(Over)  
JAN 16 1952