

New Location   
 Drill Deeper   
 Abandonment

MAR 23 1953

Company SOUTH PENN NATURAL GAS CO.  
 Address PARKERSBURG, W. VA.  
 Farm S. B. BARE (BANNISTER HRS.)  
 Tract \_\_\_\_\_ Acres 540 Lease No. \_\_\_\_\_  
 Well (Farm) No. 15 & 16 Serial No. F-1384  
F-1385  
 Elevation (Spirit Level) \*15-801.9, \*16-743.4  
 Quadrangle CLENDENIN  
 County KANAWHA District ELK  
 Engineer PAUL E. JOACHIM  
 Engineer's Registration No. 669  
 File No. 70-72-65 Drawing No. \_\_\_\_\_  
 Date MAR. 3, 1953 Scale 1"=400'

STATE OF WEST VIRGINIA  
 DEPARTMENT OF MINES  
 OIL AND GAS DIVISION  
 CHARLESTON

WELL LOCATION MAP  
 FILE NO. KAN-979-A-#15  
KAN-980-A-#16

+ Denotes location of well on United States Topographic Maps, scale 1 to 62,500, latitude and longitude lines being represented by border lines as shown.  
 - Denotes one inch spaces on border line of original tracing.

S. B. BARE (BANNISTER HRS.) Nos. 15 & 16 - SOUTH PENN N. G. Co. - KAN-979-980-A

STATE OF WEST VIRGINIA  
DEPARTMENT OF MINES  
OIL AND GAS DIVISION

1758

WELL RECORD

Permit No. KAW-979-A


Oil or Gas Well Oil  
(KIND)

Company South Penn Natural Gas Company  
 Address Parkersburg, West Virginia  
 Farm Bannister Heirs Acres 540  
 Location (waters) \_\_\_\_\_  
 Well No. 15 Elev. 801.9  
 District Elk County Kenawa  
 The surface of tract is owned in fee by Bannister Heirs  
Jas. Hoover Address Mine Creek, W. Va.  
 Mineral rights are owned by Minnie L. Reese, et al.  
22 Kanawha Blvd.  
 Address Charleston, W. Va.  
 Drilling commenced \_\_\_\_\_  
 Drilling completed May 4, 1927  
 Date shot \_\_\_\_\_ Depth of shot \_\_\_\_\_  
 Open Flow \_\_\_\_\_ /10ths Water in \_\_\_\_\_ Inch  
 \_\_\_\_\_ /10ths Merc. in \_\_\_\_\_ Inch  
 Volume \_\_\_\_\_ Cu. Ft.  
 Rock Pressure \_\_\_\_\_ lbs. \_\_\_\_\_ hrs.  
 Oil \_\_\_\_\_ bbls., 1st 24 hrs.  
 Fresh water 1005 feet \_\_\_\_\_ feet  
 Salt water \_\_\_\_\_ feet \_\_\_\_\_ feet

Casing and Tubing	Used in Drilling	Left in Well	Packers
Size			Kind of Packer
16			
13			
10			Size of
8 1/4	<u>1582' 11"</u>	<u>1582' 11"</u>	Depth set
6 5/8			
5 3/16			
3			Perf. top
2	<u>1865' 8"</u>	<u>1865' 8"</u>	Perf. bottom
Liners Used			Perf. top
			Perf. bottom

CASING CEMENTED \_\_\_\_\_ SIZE \_\_\_\_\_ No. Ft. \_\_\_\_\_ Date \_\_\_\_\_  
 COAL WAS ENCOUNTERED AT 305' FEET 8 1/2 INCHES  
 FEET INCHES FEET INCHES  
 FEET INCHES FEET INCHES

Formation	Color	Hard or Soft	Top	Bottom	Oil, Gas or Water	Depth Found	Remarks
Coal			305	312			
Salt Sand			940	1375	Water	1005	
Maxon Sand			1470	1490			
Little Line			1504	1545			
Pencil Cave			1545	1552			
Big Line			1552	1680	Oil and Gas	1608	
Big Injun			1680	1720			
Squaw Sand			1822	1847	Oil and Gas	1827	
Total Depth				1868			

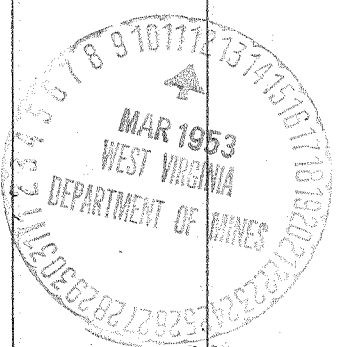

JUN 10 1953

