

Company SOUTH PENN NATURAL GAS CO.

Address PARKERSBURG, W. VA.

Farm S. B. BARE (BANNISTER HRS.)

Tract _____ Acres 540 Lease No. _____

Well (Farm) No. 15 & 16 Serial No. F-1384
F-1385

Elevation (Spirit Level) *15-801.9, *16-743.4

Quadrangle CLENDENIN

County KANAWHA District ELK

Engineer PAUL E. JOACHIM

Engineer's Registration No. 669

File No. 70-72-65 Drawing No. _____

Date MAR. 3, 1953 Scale 1"=400'

STATE OF WEST VIRGINIA
DEPARTMENT OF MINES
OIL AND GAS DIVISION
CHARLESTON

WELL LOCATION MAP

FILE NO. KAN-979-A-#15
KAN-980-A-#16

+ Denotes location of well on United States Topographic Maps, scale 1 to 62,500, latitude and longitude lines being represented by border lines as shown.

- Denotes one inch spaces on border line of original tracing.

S. B. BARE (BANNISTER HRS) Nos. 15 & 16 - SOUTH PENN N.G. Co. - KAN-979-980-A

STATE OF WEST VIRGINIA
DEPARTMENT OF MINES
OIL AND GAS DIVISION

1759

WELL RECORD

Permit No. KAW-980-A


Oil or Gas Well Oil
(KIND)

Company South Penn Natural Gas Company
Address Parkersburg, West Virginia
Farm Bannister Heirs Acres 540
Location (waters) _____
Well No. 16 Elev. 743.4
District Elk County Kanawha
The surface of tract is owned in fee by Bannister Heirs
Jas. Hoover Address Blue Creek, W.Va.
Mineral rights are owned by Minnie L. Reese, et al.
Address 22 Kanawha Blvd. Charleston, W.Va.
Drilling commenced _____
Drilling completed April 30, 1928
Date shot _____ Depth of shot _____
Open Flow /10ths Water in _____ Inch
/10ths Merc. in _____ Inch
Volume _____ Cu. Ft.
Rock Pressure _____ lbs. _____ hrs.
Oil _____ bbls., 1st 24 hrs.
Fresh water 995 feet 1690 & 1700 feet
Salt water _____ feet _____ feet

Casing and Tubing	Used in Drilling	Left in Well	Packers
Size			
16			Kind of Packer
13			
10			Size of
8 3/4	1556	1556	Depth set
6 5/8	1724	1724	
5 3/16			Perf. top
3			Perf. bottom
2	1850	1850	Perf. top
Liners Used			Perf. bottom

CASING CEMENTED _____ SIZE _____ No. Ft. _____ Date _____
COAL WAS ENCOUNTERED AT _____ FEET _____ INCHES
_____ FEET _____ INCHES _____ FEET _____ INCHES
_____ FEET _____ INCHES _____ FEET _____ INCHES

Formation	Color	Hard or Soft	Top	Bottom	Oil, Gas or Water	Depth Found	Remarks
Slate & Sand			150	935			
Salt Sand			935	1353	Water	995	
Maxon Sand			1434	1472			
Little Line			1476	1505			
Pencil Cave			1505	1510			
Big Line			1510	1665			
Big Injun			1665	1705	Water	1690 & 1700	
Squaw Sand			1812	1827	Oil	1813	
Total Depth				1848			

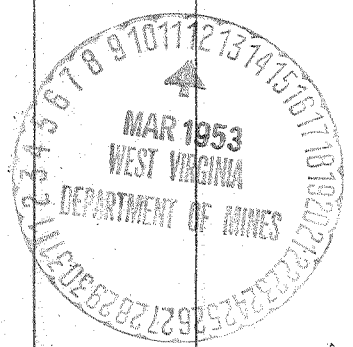

JUN 10 1953

