

New Location...
 Drill Deeper.....
 Abandonment.....

APR 7 1953

Company SOUTH PENN NATURAL GAS CO.
 Address PARKERSBURG, W. VA.
 Farm CHLOE WERTZ
 Tract _____ Acres 52 1/2 Lease No. _____
 Well (Farm) No. 1+2 Serial No. F-1915
 Elevation (Spirit Level) *1-864; *2-851
 Quadrangle CHARLESTON
 County KANAWHA District ELK
 Engineer PAUL E. JOACHIM
 Engineer's Registration No. 669
 File No. 68-63 Drawing No. _____
 Date MARCH 11, 1953 Scale 1" = 400'

STATE OF WEST VIRGINIA
 DEPARTMENT OF MINES
 OIL AND GAS DIVISION
 CHARLESTON

WELL LOCATION MAP
 FILE NO. KAN-981-A-#1
KAN-982-A-#2

+ Denotes location of well on United States Topographic Maps, scale 1 to 62,500, latitude and longitude lines being represented by border lines as shown.

- Denotes one inch spaces on border line of original tracing.

CHLOE WERTZ TRS, 1 & 2 - SOUTH PENN NAT GAS CO - KAN-981-2-A

STATE OF WEST VIRGINIA
DEPARTMENT OF MINES
OIL AND GAS DIVISION

1766

WELL RECORD

Permit No.


Oil or Gas Well Oil
(KIND)

Company South Penn Natural Gas Company
Address Parkersburg, West Virginia
Farm Chloe Wertz Acres 53
Location (waters)
Well No. 1 Elev.
District Elk County Kanawha
The surface of tract is owned in fee by W. W. Wertz
Route #1 Address Elkview, W. Va.
Mineral rights are owned by W. W. Wertz
Route #1 Address Elkview, W. Va.
Drilling commenced
Drilling completed January 11, 1913
Date shot Depth of shot
Open Flow /10ths Water in Inch
/10ths Merc. in Inch
Volume Cu. Ft.
Rock Pressure lbs. hrs.
Oil bbls., 1st 24 hrs.
Fresh water feet feet
Salt water feet feet

Casing and Tubing	Used in Drilling	Left in Well	Packers
Size			
16			Kind of Packer
13			
10			Size of
8 1/4	486	486	
6 5/8	1640	1640	Depth set
5 3/16			
3			Perf. top
2			Perf. bottom
Liners Used			Perf. top
			Perf. bottom

CASING CEMENTED SIZE No. Ft. Date
COAL WAS ENCOUNTERED AT 240 FEET INCHES
..... FEET INCHES FEET INCHES
..... FEET INCHES FEET INCHES

Formation	Color	Hard or Soft	Top	Bottom	Oil, Gas or Water	Depth Found	Remarks
Coal			240	246			
Salt Sand			955	1500			
Maxon Sand			1502	1573			
Little Lime			1577	1600			
Pencil Cave			1600	1617			
Big Lime			1617	1755			
Big Injun			1755	1790			
Squaw Sand			1886	1901	Oil & Gas	1886'	
					Oil & Gas	2038'	
Total Depth				2061			

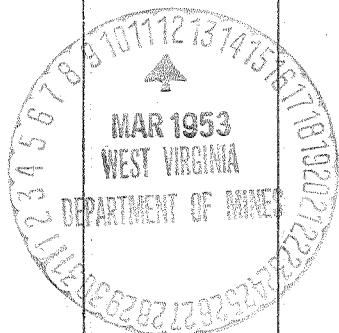

JUN 10 1953

