

New Location
 Drill Deeper
 Abandonment

MAY 2 1953

Company	<u>The Pure Oil Co.</u>
Address	<u>Newark, Ohio</u>
Farm	<u>Williams Coal Co.</u>
Tract	Acres <u>12000</u> Lease No. <u>5012</u>
Well (Farm) No.	<u>63</u> Serial No. <u>408</u>
Elevation (Spirit Level)	<u>883</u>
Quadrangle	<u>Montgomery</u>
County	<u>Kanawha</u> District <u>Cabin Creek</u>
Engineer	<u>J. J. Hunter</u>
Engineer's Registration No.	<u>Ohio-2912</u>
File No.	Drawing No.
Date	<u>2-23-53</u> Scale <u>1" = 200'</u>

STATE OF WEST VIRGINIA
 DEPARTMENT OF MINES
 OIL AND GAS DIVISION
 CHARLESTON

WELL LOCATION MAP
 FILE NO. KAN-990-A

+ Denotes location of well on United States Topographic Maps, scale 1 to 62,500, latitude and longitude lines being represented by border lines as shown.

- Denotes one inch spaces on border line of original tracing.



STATE OF WEST VIRGINIA
DEPARTMENT OF MINES
OIL AND GAS DIVISION

1788

WELL RECORD

Permit No. 990-A

Oil or Gas Well Oil
(KIND)


Company The Pure Oil Company
Address P.O. Box - 551, Newark, Ohio
Farm Williams Coal Company Acres 12,000
Location (waters) Cabin Creek
Well No. 63 Elev. 883
District Cabin Creek County Kanawha
The surface of tract is owned in fee by Shonk Land Co.
802 Kan. Bkng. Trust Co. Bldg., Charleston, W. Va.
Address
Mineral rights are owned by Ditto
Address
Drilling commenced November 1, 1916
Drilling completed February 3, 1917
Date Shot 2-6-17 From 2542 To 2555
With 60 Qts. glycerin
Open Flow /10ths Water in _____ Inch
/10ths Merc. in _____ Inch
Volume _____ Cu. Ft.
Rock Pressure _____ lbs. _____ hrs.
Oil 67 bbls., 1st 24 hrs.
Fresh water _____ feet
Salt water 340 feet

Casing and Tubing	Used in Drilling	Left in Well	Packers
Size			
16			Kind of Packer
13			
10	<u>504'</u>	<u>504'</u>	Size of
8 1/4	<u>1280'</u>	<u>Pulled</u>	
6 5/8	<u>1887'</u>	<u>1887'</u>	Depth set
5 3/16			
3			Perf. top
2	<u>2544'</u>	<u>2544'</u>	Perf. bottom
Liners Used			Perf. top
			Perf. bottom

CASING CEMENTED _____ SIZE _____ No. Ft. _____ Date _____

COAL WAS ENCOUNTERED AT 106 FEET 48 INCHES
236 FEET 24 INCHES 344 FEET 24 INCHES
_____ FEET _____ INCHES _____ FEET _____ INCHES

Formation	Color	Hard or Soft	Top	Bottom	Oil, Gas or Water	Depth Found	Remarks
Surface gravel			0	4			
Slate			4	54			
Sand			54	62			
Slate			62	96			
Line			96	106			
Coal			106	110			
Slate			110	144			
Line			144	169			
Slate			169	181			
Sand			181	236			
Coal			236	238			
Sand			238	294			
Slate			294	344			
Coal			344	346			
Line			346	361			
Sand			361	391			
Line			391	404			
Slate			404	406			
Line			406	418			
Slate			418	463			
Line			463	471			
Slate			471	571			
Sand			571	596			
Line			596	616			
Slate			616	626			
Line			626	664			
Slate			664	678			
Grampus Sand			678	878			
Slate			878	880			
Salt Sand			880	1213			
Slate			1213	1215			
Line			1215	1270			
Slate			1270	1310			
Line			1310	1330			
Slate			1330	1405			
Sand			1405	1455			
Red Rock			1455	1510			
Line			1510	1540			
					water	840'	H.F.W.

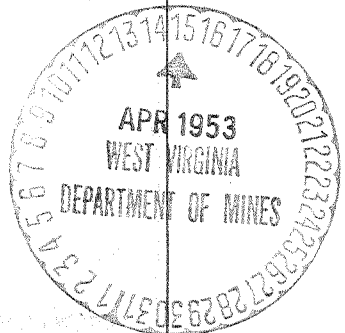

(Over) JAN 2 1954
JAN 2 REC'D

Formation	Color	Hard or Soft	Top	Bottom	Oil, Gas or Water	Depth Found	Remarks
Slate			1540	1590			
Red Rock			1590	1650			
Slate			1650	1710			
Gritty Lime			1710	1727			
Slate			1727	1762			
Maxon Sand			1762	1772			
Slate			1772	1778			
Lime			1778	1825			
Slate			1825	1852			
Little Lime			1852	1872			
Pencil Cave			1872	1878			
BIG LIME			1878	2092			
INJUN SAND			2092	2114			
Slate & shells			2114	2522 $\frac{1}{2}$			
BERBA GRIT			2522 $\frac{1}{2}$	2555	Oil	2544-2555	
TOTAL DEPTH				2557			
T.B. after C.O.				2560			

Date February 27, 19 53

APPROVED THE PURE OIL COMPANY
Box 551 - Newark, Ohio, Owner

By Guy J. Anderson
 Division Superintendent