

Company The Pure Oil Co.  
 Address Newark, Ohio.  
 Farm Williams Coal Co.  
 Tract \_\_\_\_\_ Acres 12000 Lease No. 5012  
 Well (Farm) No. 66 Serial No. 409  
 Elevation (Spirit Level) 958  
 Quadrangle Montgomery  
 County Kanawha District Cabin Creek  
 Engineer J. J. Hunter  
 Engineer's Registration No. Ohio - 2912  
 File No. \_\_\_\_\_ Drawing No. \_\_\_\_\_  
 Date 2-23-53 Scale 1" = 200'

STATE OF WEST VIRGINIA  
 DEPARTMENT OF MINES  
 OIL AND GAS DIVISION  
 CHARLESTON

WELL LOCATION MAP  
 FILE NO. KAN-992-A

+ Denotes location of well on United States Topographic Maps, scale 1 to 62,500, latitude and longitude lines being represented by border lines as shown.

- Denotes one inch spaces on border line of original tracing.





STATE OF WEST VIRGINIA  
DEPARTMENT OF MINES  
OIL AND GAS DIVISION

1789

WELL RECORD

Permit No. 992-A Oil or Gas Well Oil (KIND)

Company The Pure Oil Company  
Address P.O. Box 551 - Newark, Ohio  
Farm Williams Coal Company Acres 12,000  
Location (waters) Cabin Creek  
Well No. 66 Elev. 958  
District Cabin Creek County Kanawha  
The surface of tract is owned in fee by Shonk Land Company  
102 Kan. Bkgs. & Trust Co. Bldg. - Charleston, W. Va.  
Mineral rights are owned by Ditto  
Address \_\_\_\_\_  
Drilling commenced February 1917  
Drilling completed June 8, 1917  
Date Shot 6-8-17 From 2614 To 2619  
With 20 qts. glycerin


Casing and Tubing	Used in Drilling	Left in Well	Packers
Size			
16			Kind of Packer <u>ONS disc wall packer</u>
13			
10	<u>490'</u>	<u>490'</u>	Size of <u>5-3/16"x6-5/8"</u>
8 1/4	<u>1325'</u>	<u>Pulled</u>	
6 1/2	<u>1958'</u>	<u>1958'</u>	Depth set <u>573'</u> from bottom.
5 3/16	<u>2466' 9"</u>	<u>2466' 9"</u>	
3			Perf. top _____
2	<u>2608</u>	<u>2608</u>	Perf. bottom _____
Liners Used			Perf. top _____
			Perf. bottom _____

Open Flow /10ths Water in \_\_\_\_\_ Inch  
/10ths Merc. in \_\_\_\_\_ Inch  
Volume \_\_\_\_\_ Cu. Ft.  
Rock Pressure \_\_\_\_\_ lbs. \_\_\_\_\_ hrs.  
Dil 37 bbls., 1st 24 hrs.  
Fresh water \_\_\_\_\_ feet \_\_\_\_\_ feet  
Salt water \_\_\_\_\_ feet \_\_\_\_\_ feet

CASING CEMENTED \_\_\_\_\_ SIZE \_\_\_\_\_ No. Ft. \_\_\_\_\_ Date \_\_\_\_\_

COAL WAS ENCOUNTERED AT 65 FEET 36 INCHES  
285 FEET 60 INCHES FEET INCHES  
FEET INCHES FEET INCHES

Formation	Color	Hard or Soft	Top	Bottom	Oil, Gas or Water	Depth Found	Remarks
Gravel			0	14			
Sand			14	65			
Coal			65	68			
Line Stone			68	285			
Coal			285	290			
Sand			290	370			
Slate			370	425			
Sand			425	490			
Slate			490	590			
Sand			590	640			
Slate			640	750			
Sand			750	815			
Slate			815	818			
GRANFUS			818	920			
Slate			920	970			
SALT SAND			970	1325			
Slate & shells			1325	1550			
Red Rock			1550	1840			
Black Slate			1840	1925			
Little Lime			1925	1950			
BIG LIME			1950	2150			
Slate			2150	2155			
BIG INJUN			2155	2200			
Slate & shells			2200	2562			
Black Slate			2562	2592			
BEREA SAND			2592	2619	oil	2592-2619	
Brown Lime			2619	2622			
TOTAL DEPTH				2622			

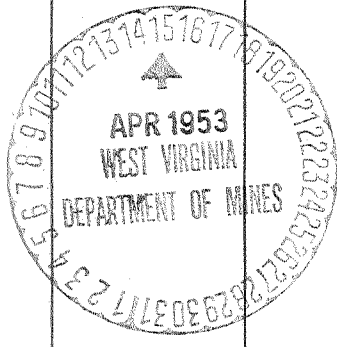

JAN 2 1954

(Over) JAN 2 RECD

