

Company UNITED FUEL GAS CO.

Address CHARLESTON W. VA.

Farm GEORGE WISEMAN

Tract _____ Acres 36 Lease No. 30344

Well (Farm) No. _____ Serial No. 4123

Elevation (Spirit Level) 850'

Quadrangle SAINT ALBANS

County KANAWHA District JEFFERSON

Engineer Seibert Russell

Engineer's Registration No. 2529

File No. 46-61 Drawing No. _____

Date 5-22-53 Scale 1" = 400'

STATE OF WEST VIRGINIA
DEPARTMENT OF MINES
OIL AND GAS DIVISION
CHARLESTON

WELL LOCATION MAP
FILE NO. KAN-1006-A

+ Denotes location of well on United States Topographic Maps, scale 1 to 62,500, latitude and longitude lines being represented by border lines as shown.

- Denotes one inch spaces on border line of original tracing.



STATE OF WEST VIRGINIA
DEPARTMENT OF MINES
OIL AND GAS DIVISION

1554

WELL RECORD

Permit No. 1006 A

Company UNITED FUEL GAS COMPANY

Address P.O. Box 1273, Charleston 25, W. Va.

Farm Geo. Wiseman Acres 36

Location (waters) 4125

Well No. Jefferson Kanawha Elev. 850

District _____ County _____

The surface of tract is owned in fee by _____ Address _____

Mineral rights are owned by _____ Address July 22, 1919

Drilling commenced _____

Drilling completed _____

Date Shot _____ From _____ To _____

With _____

Open Flow _____ /10ths Water in _____ Inch

_____ /10ths Merc. in _____ Inch

Volume _____ Cu. Ft.

Rock Pressure _____ lbs. _____ hrs.

Oil _____ bbls., 1st 24 hrs.


Fresh water _____ feet _____ feet

Salt water _____ feet _____ feet

Casing and Tubing	Used in Drilling	Left in Well	Gas	
			Oil or Gas Well	(KIND)
Size				Packers
16				Kind of Packer
13		17		Anchor
10		504		Size of 1/16"
8 1/2		1670		Depth 2287'
6 5/8		1867		
5 3/16				
3				Perf. top
2				Perf. bottom
Liners Used				Perf. top
				Perf. bottom

CASING CEMENTED	SIZE	No. Ft.	Date
		740	36
COAL WAS ENCOUNTERED AT _____ FEET _____ INCHES			
_____ FEET _____ INCHES _____ FEET _____ INCHES			
_____ FEET _____ INCHES _____ FEET _____ INCHES			

Formation	Color	Hard or Soft	Top	Bottom	Oil, Gas or Water	Depth Found	Remarks
Red Rock, Slate & Lime			450				
Sand			450	500			
Slate			500	590			
Sand			590	660			
Slate			660	690			
Sand			690	740			
Coal			740	743			
Slate			743	800			
Sand			800	835			
Slate			835	900			
Sand			900	950			
Slate			950	980			
Sand			980	1000			
Slate			1000	1105			
Salt Sand			1105	1620			
Little Lime			1620	1650			
Pencil Cave			1650	1654			
Big Lime			1654	1834			
Slate			1834	1848			
Big Injun Sand			1848	1888			
Shells			1888	2266			
Brown Shale			2266	2281			
Berea Grit			2281	2303			
Slate			2303	2315			
Total depth			2315'				
Drilled Deeper 1-14-32							
Completed 1-18-32							
Drilling Commenced 2-1-32							
Drilling Completed 2-13-32							
Started drilling deeper at 2315							
Lime Shells	2315	2333					
Total depth		2333					
					Gas 2291-2299		
					Test after shot 10/10 water in 2"		
					Volume 150,720 cu.ft. R.P. 165#		
					Shot 2-6-32 with 12 qts.		
					Steel line measure		

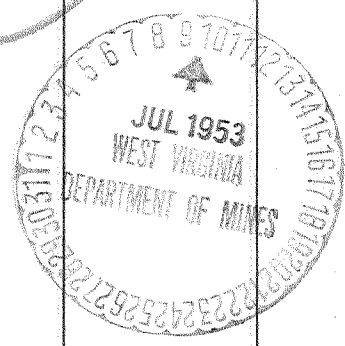

JAN 7 1955

