

New Location...   
 Drill Deeper.....   
 Abandonment.....

APR 26 1954

Company	<u>UNITED FUEL GAS CO.</u>
Address	<u>CHARLESTON, W. VA.</u>
Farm	<u>UNITED FUEL GAS CO. FEE</u>
Tract	<u>Acres 1576 DEED 27466</u>
Well (Farm) No.	<u>1</u> Serial No. <u>123</u>
Elevation (Spirit Level)	<u>804.89'</u>
Quadrangle	<u>CLENDENIN</u>
County	<u>KANAWHA</u> District <u>ELK</u>
Engineer	<u>Seybert R. Revell</u>
Engineer's Registration No.	<u>2529</u>
File No.	<u>68-61</u> Drawing No. _____
Date	<u>4-13-54</u> Scale <u>1" = 400'</u>

STATE OF WEST VIRGINIA  
 DEPARTMENT OF MINES  
 OIL AND GAS DIVISION  
 CHARLESTON

**WELL LOCATION MAP**  
 FILE NO. KAN-1031-A

+ Denotes location of well on United States Topographic Maps, scale 1 to 62,500, latitude and longitude lines being represented by border lines as shown.

- Denotes one inch spaces on border line of original tracing.

6-4 2/16



STATE OF WEST VIRGINIA  
DEPARTMENT OF MINES  
OIL AND GAS DIVISION

1855

Quadrangle Clendenin

WELL RECORD

Oil or Gas Well Gas  
(KIND)

Permit No. 1031A


Company UNITED FUEL GAS CO.  
Address P.O. Box 1273, Charleston 25, W. Va.  
Farm United Fuel Gas Co. Fee 1576 Acres  
Location (waters) Mill Creek  
Well No. 123 Elev. 804.89'  
District Elk County Kanawha  
The surface of tract is owned in fee by United Fuel Gas  
Address \_\_\_\_\_  
Mineral rights are owned by United Fuel Gas  
Address \_\_\_\_\_  
Drilling commenced \_\_\_\_\_  
Drilling completed July 23, 1909  
Date Shot \_\_\_\_\_ From \_\_\_\_\_ To \_\_\_\_\_  
With \_\_\_\_\_  
Open Flow \_\_\_\_\_ /10ths Water in \_\_\_\_\_ Inch  
\_\_\_\_\_ /10ths Merc. in \_\_\_\_\_ Inch  
Volume 1,400,000 Cu. Ft.  
Rock Pressure \_\_\_\_\_ lbs. \_\_\_\_\_ hrs.  
Oil \_\_\_\_\_ bbls., 1st 24 hrs.  
Fresh water \_\_\_\_\_ feet \_\_\_\_\_ feet  
Salt water \_\_\_\_\_ feet \_\_\_\_\_ feet

Casing and Tubing	Used in Drilling	Left in Well	Packers
Size			Kind of Packer
16			
13			
10	131		Size of
8 1/4	615		<u>2x6-5/8x16</u>
6 5/8	1341		Depth set
5 3/16		1456	<u>1569'</u>
3			Perf. top
2			Perf. bottom
Liners Used			Perf. top
			Perf. bottom

CASING CEMENTED \_\_\_\_\_ SIZE \_\_\_\_\_ No. Ft. \_\_\_\_\_ Date \_\_\_\_\_

COAL WAS ENCOUNTERED AT \_\_\_\_\_ FEET \_\_\_\_\_ INCHES  
\_\_\_\_\_ FEET \_\_\_\_\_ INCHES \_\_\_\_\_ FEET \_\_\_\_\_ INCHES  
\_\_\_\_\_ FEET \_\_\_\_\_ INCHES \_\_\_\_\_ FEET \_\_\_\_\_ INCHES

Formation	Color	Hard or Soft	Top	Bottom	Oil, Gas or Water	Depth Found	Remarks
Salt Sand				800	3" Tubing (Anchor) 170'		
Top Big Lime				1456			
Gas in Lime				1580			
Bottom of Lime				1605			
Red Sand Top				1605			
Red Sand Bottom				1630			
White Sand Top				1684			
Gas in White Sand				1684			
Bottom White Sand				1739			
Total depth				1739			

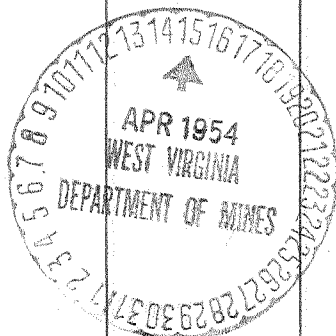

JAN 7 1955

