

New Location
 Drill Deeper
 Abandonment

MAY 3 1954

2.02 W
 3.77 Q

Company UNITED FUEL GAS CO.
 Address CHARLESTON, W. VA.
 Farm A. B. PAULEY
 Tract _____ Acres 202 Lease No. 11297
 Well (Farm) No. 2 Serial No. 1796
 Elevation (Spirit Level) 794.00
 Quadrangle WALTON
 County KANAWHA District ELK
 Engineer Jaybert R. Ferrell
 Engineer's Registration No. 2529
 File No. 70-71 Drawing No. _____
 Date 4-13-54 Scale 1" = 400'

STATE OF WEST VIRGINIA
 DEPARTMENT OF MINES
 OIL AND GAS DIVISION
 CHARLESTON

WELL LOCATION MAP
 FILE NO. KAN-1035-A

+ Denotes location of well on United States Topographic Maps, scale 1 to 62,500, latitude and longitude lines being represented by border lines as shown.

- Denotes one inch spaces on border line of original tracing.

A. B. PAULEY No. 2 (1796) - U.F.G. Co. - KAN 1035-A



STATE OF WEST VIRGINIA
DEPARTMENT OF MINES
OIL AND GAS DIVISION

1824

Quadrangle Walton

WELL RECORD

Permit No. 2354

Oil or Gas Well Gas
(KIND)

Company UNITED FUEL GAS CO.
Address P.O. Box 1273, Charleston 25, W. Va.
Farm A. B. Pauley Acres 202
Location (waters) Little Sandy Creek
Well No. 1796 Elev. 794'
District Big Sandy County Kanawha
The surface of tract is owned in fee by _____
Address _____
Mineral rights are owned by Lillian S. Robertson,
21 1/2 Capitol St. Address Charleston, W. Va.
Drilling commenced Nov. 25, 1926
Drilling completed March 2, 1927
Date Shot _____ From _____ To _____
With _____
Open Flow 20 /10ths Water in _____ 2 Inch
_____ /10ths Merc. in _____ Inch
Volume 189,000 Cu. Ft.
Rock Pressure 212 lbs. _____ hrs.
Oil _____ bbls., 1st 24 hrs.
Fresh water 188' feet _____ feet
Salt water _____ feet _____ feet


Casing and Tubing	Used in Drilling	Left in Well	Packers
Size			
16			Kind of Packer _____
18			Shoe _____
10	<u>410</u>		Size of _____
8 1/4	<u>965</u>		<u>6-5/8"</u>
6 3/4	<u>1600</u>		Depth set _____
5 3/16			
3	<u>1824</u>		Perf. top _____
2			Perf. bottom _____
Liners Used			Perf. top _____
			Perf. bottom _____

CASING CEMENTED _____ SIZE _____ No. Ft. _____ Date _____

COAL WAS ENCOUNTERED AT 646 FEET 48 INCHES
_____ FEET _____ INCHES FEET _____ INCHES
_____ FEET _____ INCHES FEET _____ INCHES

Formation	Color	Hard or Soft	Top	Bottom	Oil, Gas or Water	Depth Found	Remarks
Red Rock				60			
Lime			60	140			
Slate & Shells			140	180			
Sand			180	200			
Red Rock			200	2 244			
Slate & Shells			244	361			
Sand			361	381			
Sand			381	415			
Sand			415	496			
Slate & Shells			496	646			
Coal			646	650			
Slate			650	663			
Sand			663	750			
Slate & Shells			750	780			
Black Slate			780	800			
Slate & Shells			800	885			
Sand			885	924			
Slate			924	929			
Lime			929	944			
Sandy Lime			944	971			
Slate & Shells			971	1073			
Salt Sand			1073	1521			
Slate			1521	1522			
Sand			1522	1570			
Black Lime			1570	1582			
Slate			1582	1584			
Sand Shells			1584	1587			
Slate			1587	1592			
Big Lime			1592	1731			
Injun Sand			1731	1766			
Slate & Shells			1766	1812			
Total depth			1812				

Water at 188'

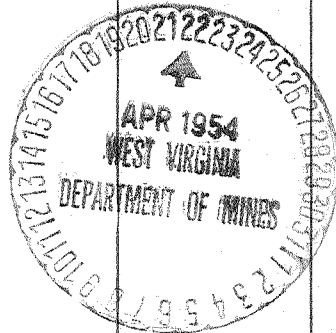

Pay 1732 and 1745'

JAN 7 1955

