

Latitude $38^{\circ} 35'$

Longitude $81^{\circ} 20'$

New Location
 Drill Deeper
 Abandonment

MAY 3 1954

*179 W
 5.02 2*

Company UNITED FUEL GAS CO.
 Address CHARLESTON, W.VA.
 Farm WILSON & ANNIE WOODS
 Tract _____ Acres 200 Lease No. 2145
 Well (Farm) No. 1 Serial No. 31
 Elevation (Spirit Level) 614.00'
 Quadrangle WALTON
 County KANAWHA District BIG SANDY
 Engineer Frank E. Jodanis
 Engineer's Registration No. 669
 File No. 76-69 Drawing No. _____
 Date 4-21-54 Scale 1"=400'

STATE OF WEST VIRGINIA
 DEPARTMENT OF MINES
 OIL AND GAS DIVISION
 CHARLESTON

WELL LOCATION MAP
 FILE NO. KAN-1036-A

+ Denotes location of well on United States Topographic Maps, scale 1 to 62,500, latitude and longitude lines being represented by border lines as shown.

- Denotes one inch spaces on border line of original tracing.

WILSON & ANNIE WOODS NO. 1 (31) - U, F, G, C, - KAN-1036-A



STATE OF WEST VIRGINIA
DEPARTMENT OF MINES
OIL AND GAS DIVISION

18556

Quadrangle Walton

WELL RECORD

Oil or Gas Well Gas
(KIND)

Permit No. AP 1036A

Company UNITED FUEL GAS COMPANY
Address P.O. Box 1273, Charleston 25, W. Va.
Farm Wilson & Annie Wood Acres 200
Location (waters) Big Sandy Creek
Well No. 31 Elev. 614'
District Big Sandy County Kanawha
The surface of tract is owned in fee by _____
Address _____
Mineral rights are owned by Howard James Young, et al
Route 1 Address Clendenin, W. Va.
Drilling commenced Aug. 29, 1906
Drilling completed Oct. 30, 1906
Date Shot _____ From _____ To _____
With _____
Open Flow _____ /10ths Water in _____ Inch
_____ /10ths Merc. in _____ Inch
Volume 4,039,000 Cu. Ft.
Rock Pressure 505 lbs. _____ hrs.
Oil _____ bbls., 1st 24 hrs.
Fresh water _____ feet _____ feet
Salt water _____ feet _____ feet

Casing and Tubing	Used in Drilling	Left in Well	Packers
Size			
16			Kind of Packer <u>Dresser</u>
18			
10		<u>40</u>	Size of <u>4x6-5/8</u>
8 1/2	<u>438</u>		Depth set
6 5/8		<u>1383</u>	
5 3/16			Perf. top
3			Perf. bottom
2			Perf. top
Liners Used			Perf. bottom

CASING CEMENTED _____ SIZE _____ No. Ft. _____ Date _____

COAL WAS ENCOUNTERED AT 160 FEET 36 INCHES
570 FEET 36 INCHES FEET INCHES
FEET INCHES FEET INCHES

Formation	Color	Hard or Soft	Top	Bottom	Oil, Gas or Water	Depth Found	Remarks
Slate & Sand			0	160			
Coal			160	163			
Sand			163	310			
Slate			310	380			
Sand			380	410			
Slate			410	415			
Sand			415	438			
Slate			438	440			
Sand			440	450			
Slate & Lime			450	570			
Coal			570	573			
Slate & Sand			573	700			
Slate & Lime			700	800			
Sand			800	830			
Salt Sand			830	1153			
Slate			1153	1200			
Sand			1200	1320			
Little Lime			1320	1348			
Pencil Cave			1348	1353			
Big Lime			1353	1510			
Big Injun			1510	1547			
Slate			1547	1552			
Bottom			1552'				


2" tubing pulled and rerun.
1st perf. on bottom, 2nd perf.
at 1525 6-5/8x2 anchor packer
set at 1464. Work done in 1923

1 2x6-5/8 x16 Par. Anchor packer.

10-24-16
1 5-3/16 Hook Wall packer
Set at 1473' Feb. 20, 1929.
Show of gas 860'

Gas pay in Big Injun

Show of gas 1432

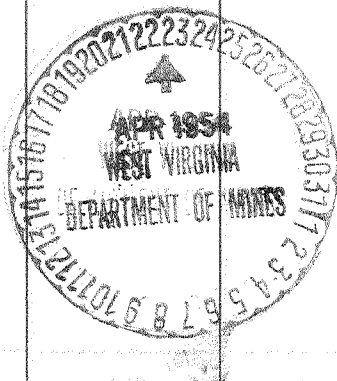

JAN 7 1955

