

New Location...
 Drill Deeper.....
 Abandonment.....

MAY 17 1954

0.58 W
3.0

Company	BLAND & TOMPKINS		
Address	CHARLESTON, W. VA.		
Farm	J. W. DIXON		
Tract	Acres	39 ²	Lease No.
Well (Farm) No.	1	Serial No.	F2506
Elevation (Spirit Level)	820		
Quadrangle	CHARLESTON		
County	KANAWHA	District	ELK
Engineer	PAUL E. JOACHIM		
Engineer's Registration No.	669		
File No.	68-61	Drawing No.	
Date	APRIL 24, 1954		
Scale	1" = 400'		

STATE OF WEST VIRGINIA
 DEPARTMENT OF MINES
 OIL AND GAS DIVISION
 CHARLESTON


WELL LOCATION MAP
 FILE NO. KAN-1039-A

+ Denotes location of well on United States Topographic Maps, scale 1 to 62,500, latitude and longitude lines being represented by border lines as shown.

- Denotes one inch spaces on border line of original tracing.

(218)

J. W. DIXON NO. 1 (F-2506) - BLAND & TOMPKINS - KAN-1039-A

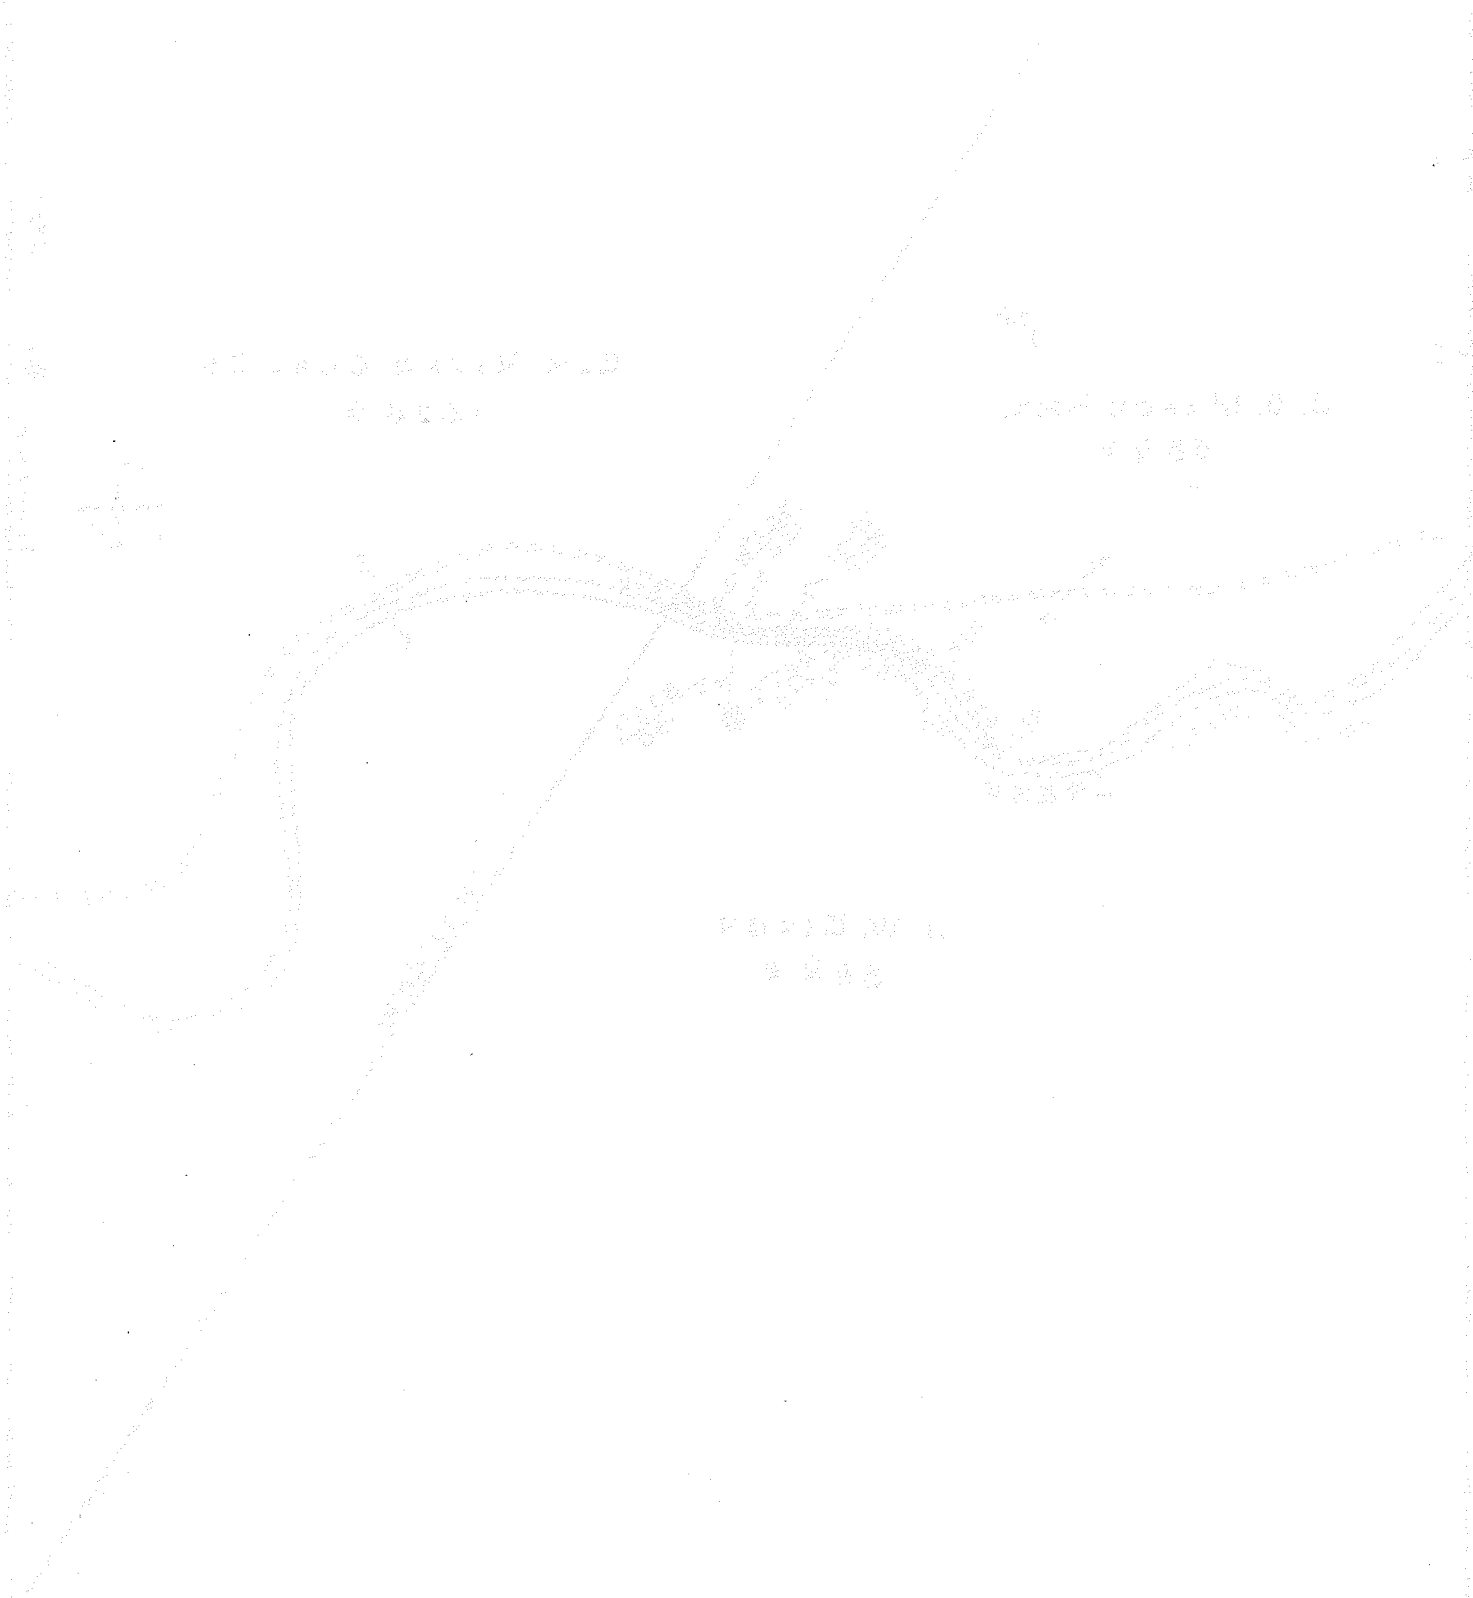

TO 1615

Weir @ TO

TO 1615
Weir @ TO

TO 1615
Weir @ TO

gas well

TO 1615
Weir @ TO