

New Location...
 Drill Deeper...
 Abandonment...

MAY 24 1954

0.42 W
 5.72

Company UNITED FUEL GAS CO.
 Address CHARLESTON, W. VA.
 Farm J.D. MATHENY
 Tract _____ Acres 75 Lease No. 11995
 Well (Farm) No. 1 Serial No. 1035
 Elevation (Spirit Level) 696.8
 Quadrangle WALTON
 County KANAWHA District BIG SANDY
 Engineer Seybert & Russell
 Engineer's Registration No. 2529
 File No. 76-69 Drawing No. _____
 Date 4-28-54 Scale 1" = 400'

STATE OF WEST VIRGINIA
 DEPARTMENT OF MINES
 OIL AND GAS DIVISION
 CHARLESTON

WELL LOCATION MAP
 FILE NO. KAN-1041-A

+ Denotes location of well on United States Topographic Maps, scale 1 to 62,500, latitude and longitude lines being represented by border lines as shown.
 - Denotes one inch spaces on border line of original tracing.



STATE OF WEST VIRGINIA
DEPARTMENT OF MINES
OIL AND GAS DIVISION

1818

Quadrangle Walton

WELL RECORD

Permit No. 1047A

Oil or Gas Well Gas
(KIND)

Company UNITED FUEL GAS COMPANY
Address P.O. Box 1273, Charleston 25, W. Va.
Farm J. D. Matheny Acres 75
Location (waters) Little Thoroughfare Run
Well No. 1035 Elev. 696.8'
District Big Sandy County Kanawha

The surface of tract is owned in fee by _____
Address _____
Mineral rights are owned by D. L. Cork, Agent, et al
231 Hale Street Charleston, W. Va.
Address _____

Drilling commenced June 6, 1918
Drilling completed July 12, 1918
Date Shot _____ From _____ To _____
With _____


Open Flow 8 /10ths Water in 6-5/8" Inch
_____ /10ths Merc. in _____ Inch
Volume 1,420,000 Cu. Ft.
Rock Pressure 270# lbs. _____ hrs.
Oil _____ bbls., 1st 24 hrs.
Fresh water 115' feet 390' feet
Salt water 930' feet 370' feet

Casing and Tubing	Used in Drilling	Left in Well	Packers
Size			Kind of Packer
16			
18			<u>Parm. Anchor</u>
10		<u>13'3"</u>	Size of
8 1/4	<u>314'</u>		<u>2"x6-5/8"</u>
6 5/8		<u>1432'</u>	Depth set
5 3/16			<u>1457</u>
3			Perf. top
2		<u>1629'</u>	Perf. bottom
Liners Used			Perf. top
			Perf. bottom

CASING CEMENTED _____ SIZE _____ No. Ft. _____ Date _____

COAL WAS ENCOUNTERED AT _____ FEET _____ INCHES
_____ FEET _____ INCHES _____ FEET _____ INCHES
_____ FEET _____ INCHES _____ FEET _____ INCHES

Formation	Color	Hard or Soft	Top	Bottom	Oil, Gas or Water	Depth Found	Remarks
Surface				11			
Sand			11	160	Water 115'		
Slate & Shell			160	310	Water 390'		
Slate			310	330	Salt Water 930'		
Sand			330	440	Gas pay from 1540'-1572'		Test
Slate			440	550	8/10 Water 6-5/8" casing		
Sand			550	580			
Slate			580	660			
Sand			660	700			
Slate			700	800			
Lime			800	830			
Salt Sand			830	1185			
Slate			1185	1210			
Lime			1210	1275			
Maxon			1275	1340			
Break			1340	1344			
Little Lime			1344	1374			
Break			1374	1380			
Lime Shell			1380	1394			
Break			1394	1397			
Lime Shell			1397	1412			
Break			1412	1414			
Big Lime			1414	1535			
Break			1535	1537			
Big Injun			1537	1577			
Slate			1577	1614			
Total depth			1614'				

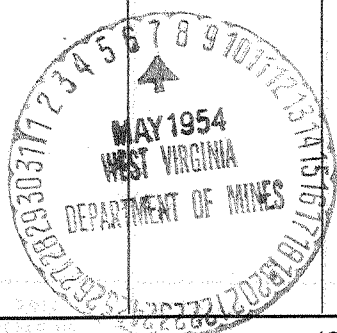

(Over)

MAY 12 1954

