

New Location
 Drill Deeper
 Abandonment

✓ JUN 28 1954

2.72 W
 2.51 W

Company UNITED FUEL GAS CO.
 Address CHARLESTON, W.VA.
 Farm J. M. HUNT
 Tract _____ Acres 40 Lease No. 18964
 Well (Farm) No. _____ Serial No. 1540
 Elevation (Spirit Level) 1073
 Quadrangle WALTON
 County KANAWHA District FLK
 Engineer Seybert R. Farrell
 Engineer's Registration No. 2529
 File No. 70-73 Drawing No. _____
 Date 6-10-54 Scale 1"=400'

STATE OF WEST VIRGINIA
 DEPARTMENT OF MINES
 OIL AND GAS DIVISION
 CHARLESTON

WELL LOCATION MAP
 FILE NO. KAN-1045-A

+ Denotes location of well on United States Topographic Maps, scale 1 to 62,500, latitude and longitude lines being represented by border lines as shown.

- Denotes one inch spaces on border line of original tracing.



STATE OF WEST VIRGINIA
DEPARTMENT OF MINES
OIL AND GAS DIVISION

1813

Quadrangle Walton

WELL RECORD

Permit No. 10457

Oil or Gas Well Gas
(KIND)


Company UNITED FUEL GAS COMPANY
Address P.O. Box 1273, Charleston 25, W. Va.
Farm J. M. Hunt Acres 40
Location (waters) Pocatalico Fork
Well No. 1540 Elev. 1140'
District Elk County Kanawha
The surface of tract is owned in fee by _____
Address _____
Mineral rights are owned by Nellie E. Hunt
Address Frame, W. Va.
Drilling commenced 2-3-26
Drilling completed 3-20-26
Date Shot _____ From _____ To _____
With _____
Open Flow 21 /10ths Water in 2 Inch
_____ /10ths Merc. in _____ Inch
Volume 215,000 Cu. Ft.
Rock Pressure 185 lbs. _____ hrs.
Oil _____ bbls., 1st 24 hrs.
Fresh water _____ feet _____ feet
Salt water 1460 feet _____ feet

Casing and Tubing	Used in Drilling	Left in Well	Packers
Size			
16			Kind of Packer _____
18			Anchor
10			Size of _____
8 1/2	720'	300'	3x5-3/16x16
6 5/8	1941'	1941'	Depth set _____
5 3/16			2029'
3	2120'	2120'	Perf. top _____
2			Perf. bottom _____
Liners Used			Perf. top _____
			Perf. bottom _____

CASING CEMENTED _____ SIZE _____ No. Ft. _____ Date _____

COAL WAS ENCOUNTERED AT _____ FEET _____ INCHES
_____ FEET _____ INCHES _____ FEET _____ INCHES
_____ FEET _____ INCHES _____ FEET _____ INCHES

Formation	Color	Hard or Soft	Top	Bottom	Oil, Gas or Water	Depth Found	Remarks
Red Rock				12			
Sand			12	23			
Slate			23	60			Hole full water 1460'
Sand			60	75			Hole reduced 1988
Slate			75	105			Lime gas 1996
Sand			105	140			Injun Gas 2042
Slate & Shells			140	210			Injun Gas 2050-2053'
Sand			210	335			
Red Rock			335	380			
Sand			380	465			
Slate & Shells			465	520			
Sand			520	550			
Red Rock & Shells			550	680			
Dunkard Sand			680	860			
Slate & Shells			860	945			
Sand			945	1025			
Slate & Shells			1025	1245			
Gas Sand			1245	1300			
Slate & Shells			1300	1390			
Salt Sand			1390	1806			
Maxon Sand			1806	1866			
Little Lime			1866	1885			
Pencil Cave			1885	1896			
Big Lime			1896	2037			
Big Injun			2037	2077			
Slate			2077	2104			
Total depth			2104				

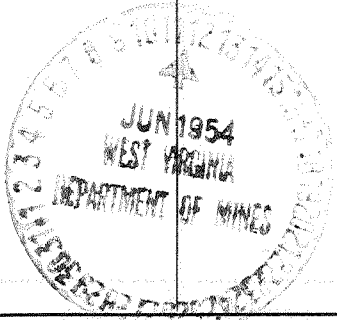

(Over)
NOV 12 1954

