

New Location..   
 Drill Deeper.....   
 Abandonment.....

JUL 13 1954

3.83 W  
 3.62 Q

Company UNITED FUEL GAS CO.  
 Address CHARLESTON, W. VA.  
 Farm B.K. LITTLEPAGE ET AL.  
 Lot 4 Tract 4 Acres .52 Lease No. 4542  
 Well (Farm) No. \_\_\_\_\_ Serial No. 1654  
 Elevation (Spirit Level) 1215.31'  
 Quadrangle WALTON  
 County KANAWHA District BIG SANDY  
 Engineer Seibert Kernell  
 Engineer's Registration No. 2529  
 File No. 74-71 Drawing No. \_\_\_\_\_  
 Date 6-23-54 Scale 1" = 400'

STATE OF WEST VIRGINIA  
 DEPARTMENT OF MINES  
 OIL AND GAS DIVISION  
 CHARLESTON

WELL LOCATION MAP  
 FILE NO. KAN-1047-A

+ Denotes location of well on United States Topographic Maps, scale 1 to 62,500, latitude and longitude lines being represented by border lines as shown.  
 - Denotes one inch spaces on border line of original tracing.



STATE OF WEST VIRGINIA  
DEPARTMENT OF MINES  
OIL AND GAS DIVISION

1840

Quadrangle Walton  
Permit No. 1047-A

WELL RECORD

Oil or Gas Well Gas  
(KIND)


Company UNITED FUEL GAS CO.  
Address P.O. Box 1273, Charleston 25, W. Va.  
Farm B. K. Littlepage, et al Acres 996  
Location (waters) Wills Creek  
Well No. 1654 Elev. 1215.31  
District Big Sandy County Kanawha  
The surface of tract is owned in fee by \_\_\_\_\_  
Address \_\_\_\_\_  
Mineral rights are owned by Rebecca Littlepage Enos  
Rt. 3, Box 116 Address Littleton, Colorado  
Drilling commenced 9-24-26  
Drilling completed 11-7-26  
Date Shot \_\_\_\_\_ From \_\_\_\_\_ To \_\_\_\_\_  
With \_\_\_\_\_  
Open Flow 20/10ths Water in 3 Inch  
\_\_\_\_\_/10ths Merc. in \_\_\_\_\_ Inch  
Volume 479,520 Cu. Ft.  
Rock Pressure 178 lbs. \_\_\_\_\_ hrs.  
Oil \_\_\_\_\_ bbls., 1st 24 hrs.  
Fresh water 1550 feet \_\_\_\_\_ feet  
Salt water \_\_\_\_\_ feet \_\_\_\_\_ feet

Casing and Tubing	Used in Drilling	Left in Well	Packers
Size			Kind of Packer
16			Anchor
18			Size of
10			3-x5-3/16"
8 1/4	700'	40'	Depth set
6 5/8		2006'	2043'
5 3/16			Perf. top
3		2208'	Perf. bottom
2			Perf. top
Liners Used			Perf. bottom

CASING CEMENTED \_\_\_\_\_ SIZE \_\_\_\_\_ No. Ft. \_\_\_\_\_ Date \_\_\_\_\_

COAL WAS ENCOUNTERED AT \_\_\_\_\_ FEET \_\_\_\_\_ INCHES  
\_\_\_\_\_ FEET \_\_\_\_\_ INCHES \_\_\_\_\_ FEET \_\_\_\_\_ INCHES  
\_\_\_\_\_ FEET \_\_\_\_\_ INCHES \_\_\_\_\_ FEET \_\_\_\_\_ INCHES

Formation	Color	Hard or Soft	Top	Bottom	Oil, Gas or Water	Depth Found	Remarks
Sand			0	115	<del>Water 2169-2194</del>		
Slate			115	140			
Red Rock			140	155	Hole full water at 1550'		
Slate			155	200	Hole reduced 2077' SL		
Sand			200	290	Gas 2134-35 32/10 W 1"		
Slate			290	315	Gas 2142 58/10 W 2"		
Red Rock			315	475	Steel line on 6-5/8" Casing 1992'		
Sand			475	500	Casing run on 6-5/8x8-1/4x10 BH Packer		
Red Rock			500	660			
Sand			660	880			
Slate			880	920			
Sand			920	1125			
Sand			1125	1295			
Sand			1295	1325			
Slate			1325	1430			
Salt Sand			1430	1480			
Slate			1480	1495			
Sand			1495	1650			
Slate			1650	1680			
Sand			1680	1810			
Slate			1810	1840			
Maxon Sand			1840	1940			
Little Lime			1940	1969			
Slate			1969	1971			
Shell			1971	1979			
Pencil Cave			1979	1985			
Big Lime			1985	2126			
Injun Sand			2126	2169'			
Lime			2169	2194			
Total depth			2194 SL				

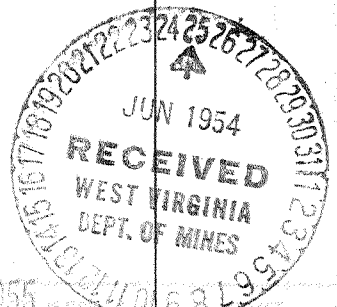

JAN 7 1955

