

New Location...
 Drill Deeper.....
 Abandonment.....

AUG 2 1954

Handwritten notes:
 4.35 W
 J.H. R

Company UNITED FUEL GAS CO.
 Address CHARLESTON, W.VA.
 Farm ELIZA JENNINGS
 Tract _____ Acres 30 Lease No. 12008
 Well (Farm) No. _____ Serial No. 1557
 Elevation (Spirit Level) 872.0'
 Quadrangle WALTON
 County KANAWHA District BIG SANDY
 Engineer Seibert Russell
 Engineer's Registration No. 2529
 File No. 78-69 Drawing No. _____
 Date 7-19-54 Scale 1"=400'

STATE OF WEST VIRGINIA
 DEPARTMENT OF MINES
 OIL AND GAS DIVISION
 CHARLESTON

WELL LOCATION MAP
 FILE NO. KAN-1053-A

+ Denotes location of well on United States Topographic Maps, scale 1 to 62,500, latitude and longitude lines being represented by border lines as shown.

- Denotes one inch spaces on border line of original tracing.

ELIZA JENNINGS No. 1557 - U.F.G.Co. - KAN-1053 A



STATE OF WEST VIRGINIA
DEPARTMENT OF MINES
OIL AND GAS DIVISION

1876

Quadrangle Clendenin

WELL RECORD

Permit No. 1034

Oil or Gas Well Gas
(KIND)


Company UNITED FUEL GAS COMPANY
Address P.O. Box 1273, Charleston 25, W. Va.
Farm Eliza A. Jennings Acres 30
Location (waters) Big Thoroughfare Run
Well No. 1557 Elev. 872'
District Big Sandy County Kanawha
The surface of tract is owned in fee by _____
Address _____
Mineral rights are owned by Stephen C. Jennings Comm.
et al Address Clendenin
Drilling commenced 10-16-25
Drilling completed 11-26-25
Date Shot _____ From _____ To _____
With _____
Open Flow 12 /10ths Water in _____ 3 Inch
_____/10ths Merc. in _____ Inch
Volume 380,000 Cu. Ft.
Rock Pressure 190 lbs. _____ hrs.
Oil _____ bbls., 1st 24 hrs.
Fresh water 225 feet _____ feet
Salt water _____ feet _____ feet

Casing and Tubing	Used in Drilling	Left in Well	Packers
Size			Kind of Packer
16			<u>Anchor</u>
13			Size of _____
10			<u>3x5-3/16x16</u>
8 1/4	<u>500'</u>	<u>416'</u>	Depth set _____
6 5/8		<u>1617'0"</u>	<u>1678'</u>
5 3/16			Perf. top _____
3		<u>1805'5"</u>	Perf. bottom _____
2			Perf. top _____
Liners Used			Perf. bottom _____

CASING CEMENTED _____ SIZE _____ No. Ft. _____ Date _____

COAL WAS ENCOUNTERED AT 420 FEET 36 INCHES
565 FEET 60 INCHES FEET INCHES
FEET INCHES FEET INCHES

Formation	Color	Hard or Soft	Top	Bottom	Oil, Gas or Water	Depth Found	Remarks
Surface			0	15	Hole full water	225	
Sand			15	100			
Slate			100	140	Reduced hole	1666'	
Sand & Slate			140	420	Gas	1726-1728 14/10 W 2"	
Coal			420	423			
Slate Shells			423	565	Gas	1738-1745 70/10 W 2"	
Coal			565	570			
Slate & Shells			570	1090			
Salt Sand			1090	1260			
Slate			1260	1270			
Sand			1270	1320			
Slate			1320	1440			
Maxon			1440	1530			
Slate			1530	1541			
Little Lime			1541	1571			
Slate			1571	1573			
Lime Shell			1573	1586			
Pencil Cave			1586	1591			
Big Lime			1591	1700			
Keener			1700	1724			
Big Injun			1724	1760			
Slate			1760	1793			
Total depth			1793				

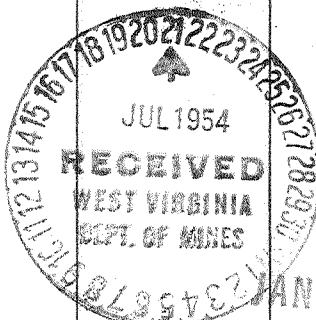

JAN 7 1955

